

TATE
B 22
7-30-70

MISSISSIPPI
BOARD OF WATER COMMISSIONERS
416 North State Street
Jackson, Mississippi 39201

CODED

WATER WELL DRILLERS LOG

~~JULY 30~~ 20 19 70 date well completed Jim Renix firm name TATE county well located

LANDOWNER: W. L. McElroy
Rt. 3
Coldwater, Miss.
(mailing address)

description of formations encountered	from	to
Dirt	0	10
Sand & Gravel	10	30
Sand	30	36

WELL LOCATION:
sec. 7 T. 4 N. R. 7 E. W
9 miles NE of Coldwater
(distance) (direction) (nearest town)

WELL PURPOSE: Home
(home, irrigation, municipal, industrial)

- WELL COMPLETION DATA:
- (1) diameter (inches) 2"
 - (2) total depth (feet) 46
 - (3) static water level (feet) 20 ^{below} ~~above~~ top of ground.
 - (4) casing Galv. Pipe,
(material) (depth)
2" & 1 1/2" if telescope see back.
(size)
 - (5) screen 48", 42"
(length) (depth to top)
1 1/2" Brass
(size) (material)
 - (6) pump Hand
(HP) (yield gpm)
Hand
(type power)
 - (7) electric log No
(yes or no)
(organization running log)
 - (8) how well bottom plugged Open


CODED

AUG 26 1970

DRILLERS REMARKS:

MISS. BD. OF
WATER COMM.

If well telescopes please sketch and show depths.

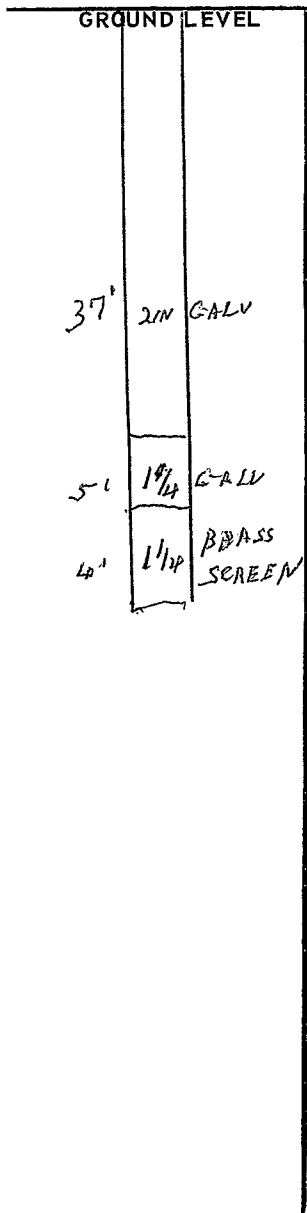

	K		

SECTION 1

Please indicate well location X.

ADDITIONAL INFORMATION

If more than one screen, show locations of each on sketch.