

TATE
B24
6-15-70

MISSISSIPPI
BOARD OF WATER COMMISSIONERS
416 North State Street
Jackson, Mississippi 39201

CODED

WATER WELL DRILLERS LOG

6-15 19 70 Harris Bros Tate
date well completed firm name county well located

LANDOWNER: Ruth Parks
P.O. #3
Coldwater
(mailing address)

description of formations encountered	from	to
top soil	0	15
red sand + peagrowel	15	40
clay + fine sand	40	120
Coarse sand	120	150

WELL LOCATION:
sec. 34 T 4 N R 7 E
2 1/2 miles E of Coldwater
(distance) (direction) (nearest town)

WELL PURPOSE: none
(home, irrigation, municipal, industrial)

- WELL COMPLETION DATA:
- (1) diameter (inches) 4
 - (2) total depth (feet) 150
 - (3) static water level (feet) 90 ^{below} top of ground.
 - (4) casing Plastic, 136'
(material) (depth)
4" if telescope see back.
(size)
 - (5) screen 14', 136'
(length) (depth to top)
008, Plastic
(size) (material)
 - (6) pump 3/4, 7
(HP) (yield gpm)
elec.
(type power)
 - (7) electric log no
(yes or no)

CODED

NOV 12 1970


(organization running log)
(8) how well bottom plugged much
shots

MISS. BD. OF
WATER COMM.

DRILLERS REMARKS:

If well telescopes please sketch and show depths.

GROUND LEVEL

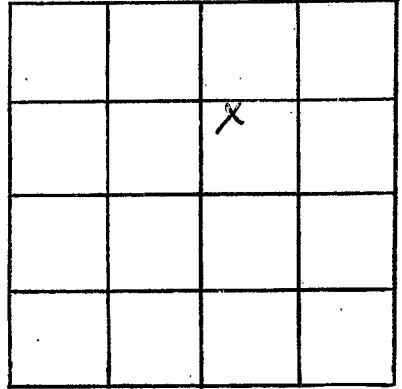

SECTION 34

Please indicate well location X.

ADDITIONAL INFORMATION

If more than one screen, show locations of each on sketch.