

TATE  
B26  
12-9-70

MISSISSIPPI  
BOARD OF WATER COMMISSIONERS  
416 North State Street  
Jackson, Mississippi 39201

**CODED**

WATER WELL DRILLERS LOG

Dec 9 1970 Shelby Meyers Tate  
date well completed firm name county well located

| LANDOWNER:        | Description of formations encountered | from | to |
|-------------------|---------------------------------------|------|----|
| Cordell's Park    | Red clay                              | 0    | 10 |
| Coldwater         | Blue clay                             | 18   | 50 |
| Miss.             | grey sand                             | 50   | 60 |
| (mailing address) |                                       |      |    |

WELL LOCATION:  
sec. 28 T 4 S R 7 W  
3 miles N, E of Coldwater  
(distance) (direction) (nearest town)

WELL PURPOSE: home  
(home, irrigation, municipal, industrial)

- WELL COMPLETION DATA:
- (1) diameter (inches) 2 0
  - (2) total depth (feet) 60
  - (3) static water level (feet) 27 below top of ground.
  - (4) casing Galvanized (material) 50 (depth)
  - (size) if telescope see back.
  - (5) screen 5 ft (length) (depth to top)  
1 1/4" Stainless Steel (size) (material)
  - (6) pump Pitcher (HP) (yield gpm)  
man (type power)
  - (7) electric log no (yes or no)  
no (organization running log)
  - (8) how well bottom plugged Rubber Seal

**CODED**


JAN 7 1971

DRILLERS REMARKS:

MISS. D. OF  
WATER COMM.

If well telescopes please sketch and show depths.

GROUND LEVEL

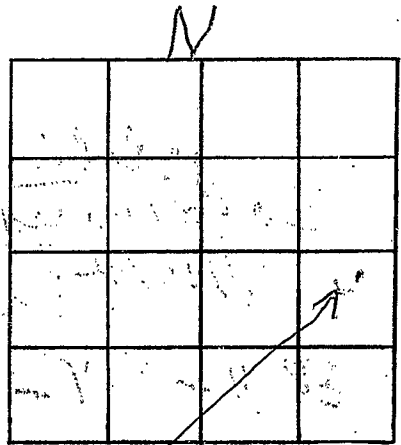

well 85 SECTION 28

Please indicate well location X.

ADDITIONAL INFORMATION

If more than one screen, show locations of each on sketch.