

TATE
B27
12-28-70

MISSISSIPPI
BOARD OF WATER COMMISSIONERS
416 North State Street
Jackson, Mississippi 39201

CODED

WATER WELL DRILLERS LOG

12-28 1970 Bob Smith Tate
date well completed firm name county well located

LANDOWNER:	description of formations encountered	from	to
M. S. Park Collwatu, Miss. (mailing address)	top soil red clay white sand	0 3 10	5 10 80
WELL LOCATION: sec. <u>28</u> T <u>4</u> N R. <u>2</u> E <u>2</u> miles <u>east</u> of <u>Collwatu</u> (distance) (direction) (nearest town)			
WELL PURPOSE: <u>None</u> (home, irrigation, municipal, industrial)			
WELL COMPLETION DATA:			
(1) diameter (inches) <u>4</u>			
(2) total depth (feet) <u>80</u>			
(3) static water level (feet) <u>30</u> below above top of ground.			
(4) casing <u>galv</u> <u>80</u> (material) (depth)			
(size) if telescope see back.			
(5) screen <u>20</u> <u>60</u> (length) (depth to top)			
(size) <u>4</u> <u>galv</u> (material)			
(6) pump <u>1/2</u> <u>10</u> (HP) (yield gpm)			
(type power) <u>Electric</u>			
(7) electric log <u>no</u> (yes or no)			
(organization running log)			
(8) how well bottom plugged <u>plugged</u>			
DRILLERS REMARKS:			


CODED

MAR 1 1971

MISS. BD. OF
WATER COMM.

If well telescopes please sketch and show depths.

GROUND LEVEL

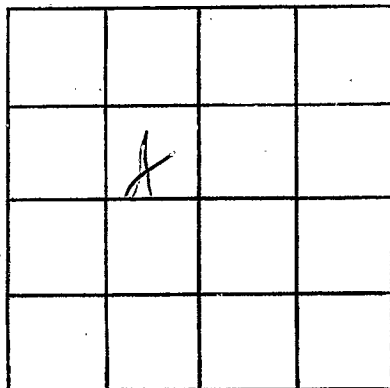

SECTION _____

Please indicate well location X.

ADDITIONAL INFORMATION

If more than one screen, show locations of each on sketch.