

MISSISSIPPI
BOARD OF WATER COMMISSIONERS
416 North State Street
Jackson, Mississippi 39201

CODED

WATER WELL DRILLERS LOG

TATE
B28
10-5-70

10-5 1970 date well completed
Harris Bros. firm name
Tate county well located

LANDOWNER: Herald Scott
pt. 3
Coldwater
(mailing address)

description of formations encountered	from	to
<u>top soil</u>	<u>0</u>	<u>15</u>
<u>clay + sand</u>	<u>15</u>	<u>85</u>
<u>Coarse sand</u>	<u>85</u>	<u>100</u>

WELL LOCATION:
sec. 27 T 4 N R. 7 E
3 1/2 miles NE of Coldwater
(distance) (direction) (nearest town)

WELL PURPOSE: none
(home, irrigation, municipal, industrial)

- WELL COMPLETION DATA:
- (1) diameter (inches) 4
 - (2) total depth (feet) 100
 - (3) static water level (feet) 60 ^{below} above top of ground.
 - (4) casing plastic, 93
(material) (depth)
4 if telescope see back.
(size)
 - (5) screen 7, 93
(length) (depth to top)
008, plastic
(size) (material)
 - (6) pump 3/4, 7
(HP) (yield gpm)
elec.
(type power)
 - (7) electric log no
(yes or no)

CODED

MAY 3 - 1971

(organization running log)


(8) how well bottom plugged weak
spud

REG. OF
MISSISSIPPI
GEOL. SURV.

DRILLERS REMARKS:

If well telescopes please sketch and show depths.

GROUND LEVEL

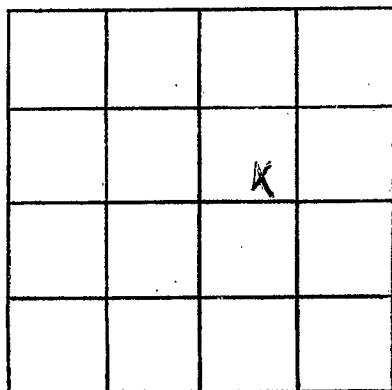

SECTION 27

Please indicate well location X.

ADDITIONAL INFORMATION

If more than one screen,
show locations of each on sketch.