

MISSISSIPPI  
BOARD OF WATER COMMISSIONERS  
416 North State Street  
Jackson, Mississippi 39201

**CODED**

WATER WELL DRILLERS LOG

TATE  
B29  
11-5-70

11-5 1970  
date well completed

R. Harris Bros. Tate  
firm name

Tate  
county well located

LANDOWNER: R.C. Part  
Pt. 3  
Coldwater  
(mailing address)

description of formations encountered	from	to
<u>top soil</u>	<u>0</u>	<u>15</u>
<u>red sand</u>	<u>15</u>	<u>25</u>
<u>clay &amp; sand</u>	<u>35</u>	<u>85</u>
<u>coarse sand</u>	<u>85</u>	<u>100</u>

WELL LOCATION:  
sec. 1 T. 4 N. R. 7 E.  
8 1/2 miles NW of Coldwater  
(distance) (direction) (nearest town)

WELL PURPOSE: Home  
(home, irrigation, municipal, industrial)

- WELL COMPLETION DATA:
- (1) diameter (inches) 4
  - (2) total depth (feet) 100
  - (3) static water level (feet) 60 <sup>below</sup>/<sub>above</sub> top of ground.
  - (4) casing plastic 93  
(material) (depth)
  - 4 If telescope see back.  
(size)
  - (5) screen 7 93  
(length) (depth to top)
  - 1008 Plastic  
(size) (material)
  - (6) pump 3/4 7  
(HP) (yield gpm)
  - elec.  
(type power)
  - (7) electric log no  
(yes or no)

**CODED**

(organization running log)

(8) how well bottom plugged wash  
shot


DRILLERS REMARKS:

MAY 3 - 1971

MISS. BD. OF  
WATER COMM.

If well telescopes please sketch and show depths.

GROUND LEVEL

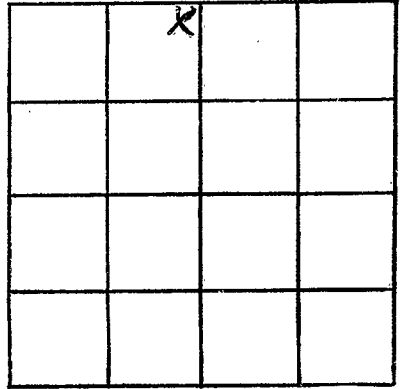

SECTION \_\_\_\_\_

Please indicate well location X.

ADDITIONAL INFORMATION

If more than one screen,  
show locations of each on sketch.