

TATE
B 30
11-15-70

MISSISSIPPI
BOARD OF WATER COMMISSIONERS
416 North State Street
Jackson, Mississippi 39201

CODED

WATER WELL DRILLERS LOG

11-15 19 70 Harris Bros. Tate
date well completed firm name county well located

LANDOWNER: Fred Stone Jr.
Rt. 2
Coldwater
(mailing address)

description of formations encountered	from	to
top sand	2	15
red sand	15	40
clay + sand	40	125
course sand	125	140

WELL LOCATION:
sec 26 T 4 N R 7 E
3 miles E of Coldwater
(distance) (direction) (nearest town)

WELL PURPOSE: home
(home, irrigation, municipal, industrial)

- WELL COMPLETION DATA:
- (1) diameter (inches) 4
 - (2) total depth (feet) 140
 - (3) static water level (feet) 80 below/above top of ground.
 - (4) casing plastic 133' (material) (depth)
4" (size) if telescope see back.
 - (5) screen 7' 133 (length) (depth to top)
008 plastic (size) (material)
 - (6) pump 3/4 10 (HP) (yield gpm)
elec. (type power)
 - (7) electric log No (yes or no)

CODED

(organization running log)


(8) how well bottom plugged suck
sand

DRILLERS REMARKS:

MISS. BD. OF WATER COMM.

If well telescopes please sketch and show depths.

GROUND LEVEL

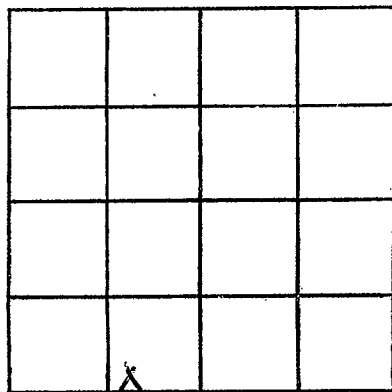

SECTION: 26

Please indicate well location X.

ADDITIONAL INFORMATION

If more than one screen,
show locations of each on sketch.