

MISSISSIPPI
BOARD OF WATER COMMISSIONERS
416 North State Street
Jackson, Mississippi 39201

CODED

WATER WELL DRILLERS LOG

TATE
B31
12-5-70

12-5 date well completed 1970 Harris Bros. firm name Tate county well located

LANDOWNER Catherine
Hamilton
Rt. 2 Coldwater
(mailing address)

description of formations encountered	from	to
top soil	0	20
red sand + pea gravel	20	40
clay + sand	40	125
coarse sand	125	140

WELL LOCATION:

sec 26 T-4 N R-7 E
3 miles E of Coldwater
(distance) (direction) (nearest town)

WELL PURPOSE: home
(home, irrigation, municipal, industrial)

WELL COMPLETION DATA:

- (1) diameter (inches) 4
- (2) total depth (feet) 140
- (3) static water level (feet) 80 below above top of ground.
- (4) casing Plastic, 133
(material) (depth)
4 (size) if telescope see back.
- (5) screen 7' 133
(length) (depth to top)
008 Plastic
(size) (material)
- (6) pump 3/4 10
(HP) (yield gpm)
elec.
(type power)
- (7) electric log no
(yes or no)

CODED

(organization running log)

(8) how well bottom plugged back
shot


MAY 14 1971

DRILLERS REMARKS:

MISS. BD. OF
WATER COMM.

If well telescopes please sketch and show depths.

GROUND LEVEL

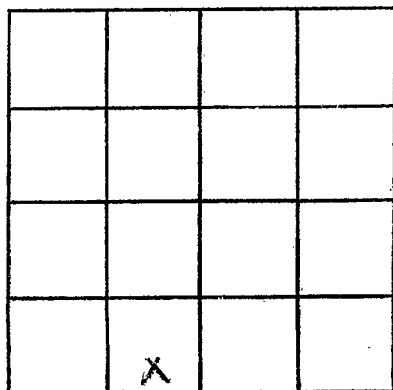

SECTION 26

Please indicate well location X.

ADDITIONAL INFORMATION

If more than one screen, show locations of each on sketch.