

TATE
B 32
12-7-70

MISSISSIPPI
BOARD OF WATER COMMISSIONERS
416 North State Street
Jackson, Mississippi 39201

CODED

WATER WELL DRILLERS LOG

12-7 1970 date well completed
Harris Bros firm name
Tate county well located

LANDOWNER: Julius Massey
pt. 3
Caldwater
(mailing address)

| description of formations encountered | from | to |
|---------------------------------------|------|-----|
| top soil | 0 | 15 |
| clay + sand | 15 | 85 |
| coarse sand | 85 | 100 |

WELL LOCATION:
sec. 15 T 4 N R 7 E
6 miles NE of Caldwater
(distance) (direction) (nearest town)

WELL PURPOSE: home
(home, irrigation, municipal, industrial)

- WELL COMPLETION DATA:
- (1) diameter (inches) 4
 - (2) total depth (feet) 100
 - (3) static water level (feet) 60 ^{below} top of ground.
 - (4) casing Plastic, 93 (material) (depth)
4" if telescope see back. (size)
 - (5) screen 7' 93 (length) (depth to top)
008, Plastic (size) (material)
 - (6) pump 3/4 7 (HP) (yield gpm)
elec. (type power)
 - (7) electric log no (yes or no)

CODED

(organization running log)

MAY 12 1971


(8) how well bottom plugged mud
shale

MISS. BD. OF
WATER COMM.

DRILLERS REMARKS:

If well telescopes please sketch and show depths.

GROUND LEVEL

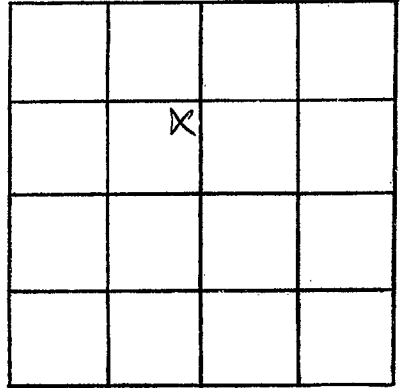

SECTION 15

Please indicate well location X.

ADDITIONAL INFORMATION

If more than one screen, show locations of each on sketch.