

TATE
B33
2-25-71

MISSISSIPPI
BOARD OF WATER COMMISSIONERS
416 North State Street
Jackson, Mississippi 39201

CODED

WATER WELL DRILLERS LOG

2-25 1971 ~~Louis Harris Bros~~ Tate
date well completed firm name county well located

LANDOWNER: Cecil Ward
pt. 2
Coldwater
(mailing address)

description of formations encountered	from	to
top soil	0	20
white clay sand	20	65
fine sand	65	105
Coarse sand	105	120

WELL LOCATION:
sec. 27 T 4 N R 7 E
3 miles NW of Coldwater
(distance) (direction) (nearest town)

WELL PURPOSE: none
(home, irrigation, municipal, industrial)

- WELL COMPLETION DATA:
- (1) diameter (inches) 4
 - (2) total depth (feet) 120
 - (3) static water level (feet) 80 ^{below} above top of ground.
 - (4) casing Plastic, 113 (material) (depth)
4 (size) if telescope see back.
 - (5) screen 7' 113 (length) (depth to top)
008 Plastic (size) (material)
 - (6) pump 3/4 10 (HP) (yield gpm)
elec. (type power)
 - (7) electric log no (yes or no)

CODED

(organization running log)

(8) how well bottom plugged brick
shot


MAY 14 1971

DRILLERS REMARKS:

MISS. BD.
WATER GU.

If well telescopes please sketch and show depths.

GROUND LEVEL

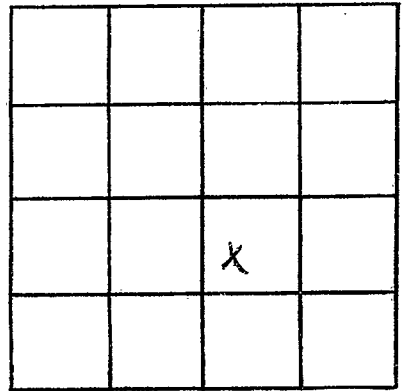

SECTION 27

Please indicate well location X.

ADDITIONAL INFORMATION

If more than one screen,
show locations of each on sketch.