

TATE
B34
10-6-71

MISSISSIPPI
BOARD OF WATER COMMISSIONERS
416 North State Street
Jackson, Mississippi 39201

CODED

WATER WELL DRILLERS LOG

10-6-1971 Bob Smith Tate
date well completed firm name county well located

LANDOWNER:
John Sanyal
Coldwater, Miss.
(mailing address)

description of formations encountered	from	to
top soil	0	5
red clay	5	20
red sand	20	40
white sand	40	80
medium sand	80	160

WELL LOCATION:
sec 21 T 4 N R 7 E
5 miles east of Coldwater
(distance) (direction) (nearest town)

WELL PURPOSE: None
(home, irrigation, municipal, industrial)

WELL COMPLETION DATA:

(1) diameter (inches) 4

(2) total depth (feet) 160

(3) static water level (feet) 100 below top of ground

(4) casing Plastic, 160 (material) (depth) (size) If telescope see back.

(5) screen 20 140 (length) (depth to top) 4 Plastic (size) (material)

(6) pump 1/2 10 (HP) (yield gpm) E hi. (type power)

(7) electric log no (yes or no)

(organization running log)

CODED

NOV 22 1971


(8) how well bottom plugged plugged

DRILLERS REMARKS:

MISS. BD. OF WATER COMMISSIONERS

If well telescopes please sketch and show depths.

GROUND LEVEL

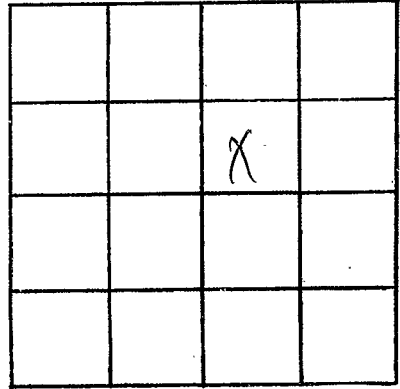

SECTION _____

Please indicate well location X.

ADDITIONAL INFORMATION

If more than one screen, show locations of each on sketch.