

TATE  
B35  
9-20-71

MISSISSIPPI  
BOARD OF WATER COMMISSIONERS  
416 North State Street  
Jackson, Mississippi 39201

**CODED**

WATER WELL DRILLERS LOG

9-20-1971 date well completed      Bob Smith firm name      Tate county well located

LANDOWNER: Bill Aekin

Independence, Miss  
(mailing address)

WELL LOCATION:  
sec. 31 T 4 N R 7 E  
5 miles west of Ind  
(distance) (direction) (nearest town)

WELL PURPOSE: None  
(home, irrigation, municipal, industrial)

description of formations encountered	from	to
top soil	0	5
red clay	5	20
red sand & gravel	20	60
fine white sand	60	100
coarse sand	100	160

WELL COMPLETION DATA:

(1) diameter (inches) 4

(2) total depth (feet) 160

(3) static water level (feet) 100 below above top of ground.

(4) casing Plastic, 160  
(material) (depth)  
(size) If telescope see back.

(5) screen 20, 140  
(length) (depth to top)  
4, Plastic  
(size) (material)

(6) pump 3/4, 15  
(HP) (yield gpm)  
Electric  
(type power)

(7) electric log no  
(yes or no)  
(organization running log)

(8) how well bottom plugged plugged

**CODED**


NOV 22 1971

MISS. BD. OF  
WATER COMMISSIONERS

DRILLERS REMARKS:

If well telescopes please sketch and show depths.

GROUND LEVEL

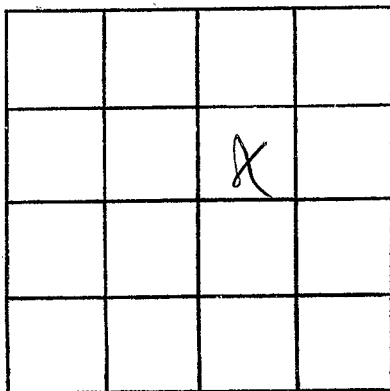

SECTION \_\_\_\_\_

Please indicate well location X.

ADDITIONAL INFORMATION

If more than one screen, show locations of each on sketch.