

TATE  
B 37  
6-10-71

MISSISSIPPI  
BOARD OF WATER COMMISSIONERS  
416 North State Street  
Jackson, Mississippi 39201

**CODED**

DEC 8 1971

WATER WELL DRILLERS LOG

MISS.

6-10 1971 Harris Bros. Tate  
date well completed firm name county well located

LANDOWNER: J. P. Tate  
pt. 2  
Caldwater  
(mailing address)

description of formations encountered	from	to
	<u>top soil</u>	<u>0</u>
<u>clay + sand</u>	<u>20</u>	<u>125</u>
<u>Coarse sand</u>	<u>125</u>	<u>140</u>

WELL LOCATION:  
sec. 26 T. 4 N. R. 7 E  
3 miles E of Caldwater  
(distance) (direction) (nearest town)

WELL PURPOSE: name  
(home, irrigation, municipal, industrial)

- WELL COMPLETION DATA:
- (1) diameter (inches) 4
  - (2) total depth (feet) 140
  - (3) static water level (feet) 80 <sup>below</sup> above top of ground.
  - (4) casing Plastic, 133  
(material) (depth)  
4 if telescope see back.  
(size)
  - (5) screen 7', 133  
(length) (depth to top)  
nos. Plastic  
(size) (material)
  - (6) pump 3/4, 10  
(HP) (yield gpm)  
elec.  
(type power)
  - (7) electric log no  
(yes or no)

**CODED**


(organization running log)

(8) how well bottom plugged back  
shot

DRILLERS REMARKS:

If well telescopes please sketch and show depths.

GROUND LEVEL

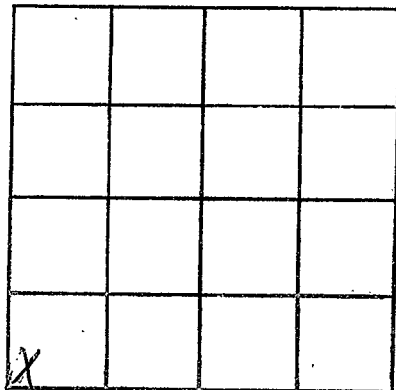

SECTION 26

Please indicate well location X.

ADDITIONAL INFORMATION

If more than one screen,  
show locations of each on sketch.