

TATE
B 38
7-11-71

MISSISSIPPI
BOARD OF WATER COMMISSIONERS
416 North State Street
Jackson, Mississippi 39201

CODED

WATER WELL DRILLERS LOG

MISS. BOARD OF
WATER COMMISSIONERS


7-11-71 date well completed 1971 Harris Bros. firm name Tate county well located

LANDOWNER:	description of formations encountered	from	to
Joe Culbreath Rt. 2 Coldwater (mailing address)	top soil	0	20
	red sand	20	55
	Clay + sand	55	140
	Coarse sand	140	170
<p>WELL LOCATION: sec 27 T 4 N R 7 E 4 miles E of Coldwater (distance) (direction) (nearest town)</p>			
<p>WELL PURPOSE: home (home, irrigation, municipal, industrial)</p>			
<p>WELL COMPLETION DATA:</p>			
(1) diameter (inches) 4			
(2) total depth (feet) 170			
(3) static water level (feet) 100 ^{below} top of ground.			
(4) casing (material) Plastic, (depth) 156			
4 (size) If telescope see back.			
(5) screen (length) 14' (depth to top) 156			
008 (size) Plastic (material)			
(6) pump 3/4 (HP) 10 (yield gpm)			
elec. (type power)			
(7) electric log no (yes or no)			
(organization running log)			
(8) how well bottom plugged back			
DRILLERS REMARKS:			

CODED

If well telescopes please sketch and show depths.

GROUND LEVEL

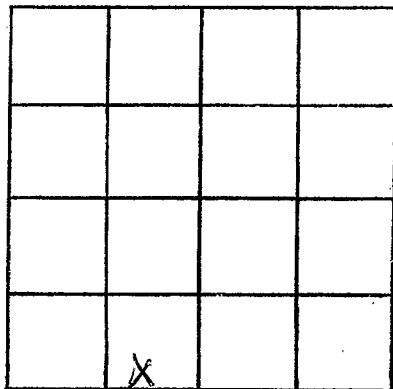

SECTION 27

Please indicate well location X.

ADDITIONAL INFORMATION

If more than one screen,
show locations of each on sketch.