

MISSISSIPPI
BOARD OF WATER COMMISSIONERS
416 North State Street
Jackson, Mississippi 39201

DEC 8 1971

CODED

WATER WELL DRILLERS LOG

TATE
B40
9-15-71

9-15-71 date well completed 71 firm name Harris Bros. Tate county well located

LANDOWNER: Fred Baker
pt. 3
Coldwater
(mailing address)

| description of formations encountered | from | to |
|---------------------------------------|-----------|------------|
| <u>top soil</u> | <u>0</u> | <u>15</u> |
| <u>clay + sand</u> | <u>15</u> | <u>85</u> |
| <u>course sand</u> | <u>85</u> | <u>100</u> |

WELL LOCATION:
sec. 27 T 4 N R 7 E
2 1/2 miles W of Coldwater
(distance) (direction) (nearest town)

WELL PURPOSE: home
(home, irrigation, municipal, industrial)

WELL COMPLETION DATA:
(1) diameter (inches) 4
(2) total depth (feet) 100
(3) static water level (feet) 60 below top of ground.
(4) casing Plastic, 93 (material), (depth)
4 (size) if telescope see back.
(5) screen 7, 93 (length), (depth to top)
008, Plastic (size), (material)
(6) pump 3/4, 10 (HP), (yield gpm)
elec (type power)
(7) electric log no (yes or no)
(organization running log)


CODED

(8) how well bottom plugged back
spot

DRILLERS REMARKS:

If well telescopes please sketch and show depths.

GROUND LEVEL

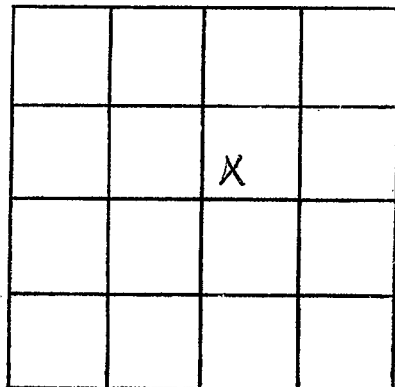

SECTION 27

Please indicate well location X.

ADDITIONAL INFORMATION

If more than one screen,
show locations of each on sketch.