

TATE
B41
1-5-72

MISSISSIPPI
BOARD OF WATER COMMISSIONERS
416 North State Street
Jackson, Mississippi 39201

MAR 20 1972


WATER WELL DRILLERS LOG

1-5-1972 date well completed Bob Smith firm name Tate county well located

LANDOWNER:	description of formations encountered	from	to
Horace Silbitt			
Coldwater, Miss. (mailing address)	top soil gravel sand	0 5 10	5 10 160
WELL LOCATION:			
sec. 27 T 4 N R 7 E 5 miles east of Coldwater (distance) (direction) (nearest town)			
WELL PURPOSE: (home, irrigation, municipal, industrial)			
WELL COMPLETION DATA:			
(1) diameter (inches) 4			
(2) total depth (feet) 160			
(3) static water level (feet) 100 below top of ground.			
(4) casing Plastic 160 (material) (depth)			
(size) If telescope see back.			
(5) screen 20 140 (length) (depth to top)			
(6) pump 4 Plastic (size) (material)			
(7) pump h 10 (HP) (yield gpm)			
(type power) E M			
(7) electric log no (yes or no)			
(organization running log)			
(8) how well bottom plugged plugged			
DRILLERS REMARKS:			

If well telescopes please sketch and show depths.

GROUND LEVEL

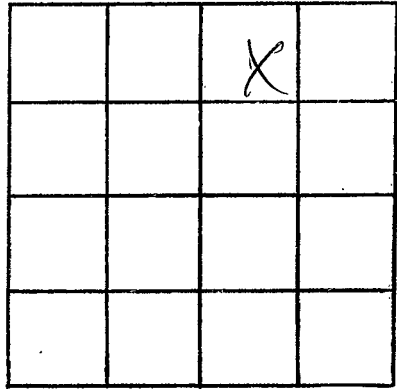

SECTION _____

Please indicate well location X.

ADDITIONAL INFORMATION

If more than one screen, show locations of each on sketch.