

TATE
B45
3-10-72

MISSISSIPPI
BOARD OF WATER COMMISSIONERS
416 North State Street
Jackson, Mississippi 39201

CODED

WATER WELL DRILLERS LOG

3-10-72 date well completed Harris Bros. firm name Tate county well located

LANDOWNER: <u>Songold Caldwell</u>	Description of formations encountered	from	to
<u>Rt. 3</u>	<u>top soil</u>	<u>0</u>	<u>20</u>
<u>Coldwater</u> (mailing address)	<u>Clay + sand</u>	<u>20</u>	<u>85</u>
WELL LOCATION: sec. <u>23</u> T <u>4</u> N R <u>7</u> E <u>5</u> miles <u>NE</u> of <u>Coldwater</u> (distance) (direction) (nearest town)	<u>Coarse sand</u>	<u>85</u>	<u>100</u>
WELL PURPOSE: <u>home</u> (home, irrigation, municipal, industrial)			
WELL COMPLETION DATA: (1) diameter (inches) <u>4</u> (2) total depth (feet) <u>100</u> (3) static water level (feet) <u>60</u> <u>below</u> top of ground. (4) casing <u>Plastic</u> , <u>93</u> (material) (depth) <u>4</u> If telescope see back. (size) (5) screen <u>7</u> , <u>93</u> (length) (depth to top) <u>008</u> , <u>Plastic</u> (size) (material) (6) pump <u>3/4</u> , <u>7</u> (HP) (yield gpm) <u>elec.</u> (type power) (7) electric log <u>no</u> (yes or no) (organization running log) (8) how well bottom plugged <u>Solid</u>			
ADDITIONAL REMARKS:			


CODED

AUG - 7 1972

MISS. Bd. OF
WATER COMMISSIONERS

If well telescopes please sketch and show depths.

GROUND LEVEL

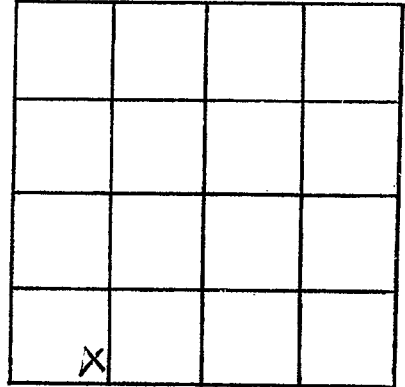

SECTION 23

Please indicate well location X.

ADDITIONAL INFORMATION

If more than one screen,
show locations of each on sketch.