

TATE
B46
1-5-72

MISSISSIPPI
BOARD OF WATER COMMISSIONERS
416 North State Street
Jackson, Mississippi 39201

CODED

WATER WELL DRILLERS LOG

1-5 1972 Harris Bros. Tate
date well completed firm name county well located

LANDOWNER: Earl & Donald Webster
pt. 1 Coldwater
(mailing address)

description of formations encountered	from	to
top soil	0	15
white clay	15	35
gray clay	35	140
fine sand	140	185
coarse sand	185	210

WELL LOCATION:
sec. 4 T 5 N R 8 E
3 miles W of Coldwater
(distance) (direction) (nearest town)

WELL PURPOSE: home
(home, irrigation, municipal, industrial)

WELL COMPLETION DATA:

- (1) diameter (inches) 4
- (2) total depth (feet) 210
- (3) static water level (feet) 80 ^{below} above top of ground.
- (4) casing Plastic, 196
(material) (depth)
- 4 if telescope see back.
(size)
- (5) screen 14 196
(length) (depth to top)
- 008, Plastic
(size) (material)
- (6) pump 3/4 10
(HP) (yield gpm)
- elec.
(type power)
- (7) electric log no
(yes or no)

CODED

(organization running log)

AUG -7 1972


(8) how well bottom plugged Solid

MISS. BD. OF
WATER COMMISSIONERS

DRILLERS REMARKS:

If well telescopes please sketch and show depths.

GROUND LEVEL

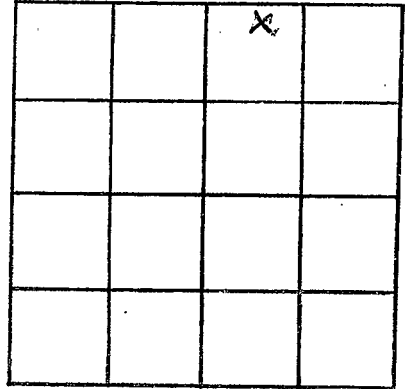

SECTION 4

Please indicate well location X.

ADDITIONAL INFORMATION

If more than one screen,
show locations of each on sketch.