

TATE
B47
7-28-72

MISSISSIPPI
 BOARD OF WATER COMMISSIONERS
 416 North State Street
 Jackson, Mississippi 39201

CODED

WATER WELL DRILLERS LOG

7-28 1972 Hicks Bros Well Co. Tate
 date well completed firm name county well located

LANDOWNER:	description of formations encountered	from	to
David Snyder	Red Clay	0	30
(mailing address)	Sand & Gravel	30	60
WELL LOCATION: sec 33 T 4 N R 8 E	white clay	60	75
3 miles West of Coldwater	white sand white sand	75	135
(distance) (direction) of (nearest town)	White Sand & Clay	135	165
WELL PURPOSE: <u>drone</u> (home, irrigation, municipal, industrial)	White Sand	165	175
WELL COMPLETION DATA:			
(1) diameter (inches) <u>4 inches</u>			
(2) total depth (feet) <u>175</u>			
(3) static water level (feet) <u>79 ft.</u> below top of ground.			
(4) casing <u>Plastic</u> , <u>175 ft.</u> (material) (depth)			
(size) if telescope see back.			
(5) screen <u>5 ft.</u> , <u>5 ft.</u> (length) (depth to top)			
<u>4 in.</u> , <u>inside gravel</u> (size) (material)			
(6) pump <u>3/4</u> <u>10 GPM.</u> (HP) (yield gpm)			
<u>Electric</u> , <u>220</u> (type power)			
(7) electric log <u>no</u> (yes or no)			
(organization running log)			
(8) how well bottom plugged <u>cap</u>			
DRILLERS REMARKS:			


CODED

AUG 17 1972

MISS. BD. OF
 WATER COMMISSIONERS

If well telescopes please sketch and show depths.

GROUND LEVEL

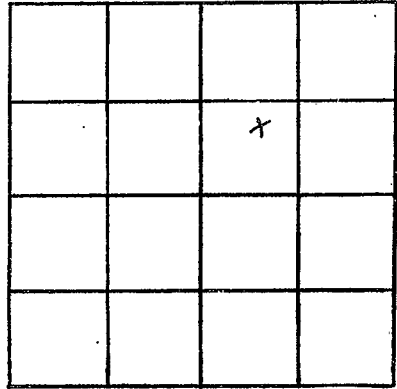

SECTION 33

Please indicate well location X.

ADDITIONAL INFORMATION

Lined area for additional information.

If more than one screen, show locations of each on sketch.