

TATE
B 48
8-30-72

MISSISSIPPI
BOARD OF WATER COMMISSIONERS
416 North State Street
Jackson, Mississippi 39201

CODED

WATER WELL DRILLERS LOG

8-30-72 date well completed 1972 firm name Bob Smith Tate county well located

LANDOWNER:	description of formations encountered	from	to
<u>Wm. Leane</u>			
<u>Coldwater, Miss.</u> (mailing address)	<u>clay</u>	<u>10</u>	<u>15</u>
WELL LOCATION:	<u>white sand</u>	<u>15</u>	<u>80</u>
sec. <u>23</u> T <u>4</u> N R <u>7</u> E			
<u>4</u> miles <u>NE</u> of <u>Coldwater</u>			
(distance) (direction) (nearest town)			

WELL PURPOSE: None
(home, irrigation, municipal, industrial)

- WELL COMPLETION DATA:
- (1) diameter (inches) 4
 - (2) total depth (feet) 80
 - (3) static water level (feet) 21 below above top of ground.
 - (4) casing Plastic 80
(material) (depth)
 - (size) if telescope see back.
 - (5) screen 20 60
(length) (depth to top)
 - (size) 4 (material) Plastic
 - (6) pump 1/2 10
(HP) (yield gpm)
 - (type power) Elec.
 - (7) electric log no
(yes or no)
 - (organization running log)
 - (8) how well bottom plugged plugged


CODED

DRILLERS REMARKS:

FEB 20 1973

If well telescopes please sketch and show depths.

GROUND LEVEL

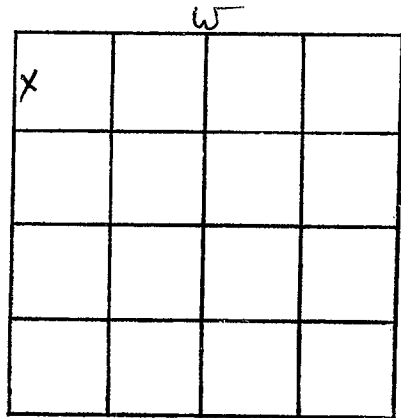

SECTION 23

Please indicate well location X.

ADDITIONAL INFORMATION

If more than one screen,
show locations of each on sketch.