

MISSISSIPPI  
BOARD OF WATER COMMISSIONERS  
416 North State Street  
Jackson, Mississippi 39201

**CODED**

WATER WELL DRILLERS LOG

TATE  
B 49  
11-21-72

11-21-1972 Bob Smith Tate  
date well completed firm name county well located

LANDOWNER:	description of formations encountered	from	to
<u>Charles Johnson</u>			
<u>Caldwater, Miss.</u> (mailing address)	<u>white clay</u>	<u>15</u>	<u>27</u>
WELL LOCATION:	<u>coarse white sand</u>	<u>27</u>	<u>103</u>
sec. <u>33</u> T <u>4</u> N R <u>8</u> E <u>S</u> <u>W</u>			
<u>3 1/2</u> miles <u>West</u> of <u>Caldwater</u> (distance) (direction) (nearest town)			
WELL PURPOSE: <u>None</u> (home, irrigation, municipal, industrial)			
WELL COMPLETION DATA:			
(1) diameter (inches) <u>4</u>			
(2) total depth (feet) <u>103</u>			
(3) static water level (feet) <u>18</u> below above top of ground.			
(4) casing <u>Plastic</u> <u>103</u> (material) (depth)			
<u>4"</u> (size) if telescope see back.			
(5) screen <u>20</u> <u>83</u> (length) (depth to top)			
<u>4</u> <u>Plastic</u> (size) (material)			
(6) pump <u>1/3</u> <u>10</u> (HP) (yield gpm)			
<u>Elec.</u> (type power)			
(7) electric log <u>no</u> (yes or no)			
(organization running log)			
(8) how well bottom plugged <u>plugged</u>			
DRILLERS REMARKS:			


**CODED**

FEB 22 1973

If well telescopes please sketch and show depths.

GROUND LEVEL

If more than one screen, show locations of each on sketch.

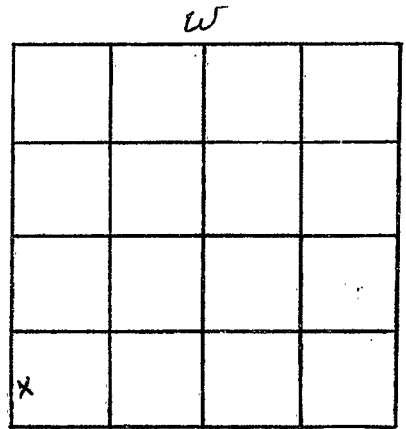

SECTION 33

Please indicate well location X.

ADDITIONAL INFORMATION