

TATE
B 50
12-26-72

MISSISSIPPI
BOARD OF WATER COMMISSIONERS
416 North State Street
Jackson, Mississippi 39201

CODED

WATER WELL DRILLERS LOG

Tate

12-26-1972 date well completed Bob Smith firm name county well located

LANDOWNER: Mrs E Sam
Coldwater - miss
(mailing address)

description of formations encountered	from	to
clay sint		10
yellow clay	10	20
gravel	20	24
Red sand	24	63
white sand	63	118

WELL LOCATION:
sec. 35 T 4N R 7E
3 miles East of Coldwater
(distance) (direction) (nearest town)

WELL PURPOSE: None
(home, irrigation, municipal, industrial)

- WELL COMPLETION DATA:
- (1) diameter (inches) 4
 - (2) total depth (feet) 118
 - (3) static water level (feet) 50 below above top of ground.
 - (4) casing Plastic, 118
(material) (depth)
 - (size) If telescope see back.
 - (5) screen 20, 98
(length) (depth to top)
 - 4, Plastic
(size) (material)
 - (6) pump 1/3, 10
(HP) (yield gpm)
 - Elec
(type power)
 - (7) electric log no
(yes or no)
 - (organization running log)
 - (8) how well bottom plugged plugged


CODED

DRILLERS REMARKS:

NOV 29 1972

If well telescopes please sketch and show depths.

GROUND LEVEL

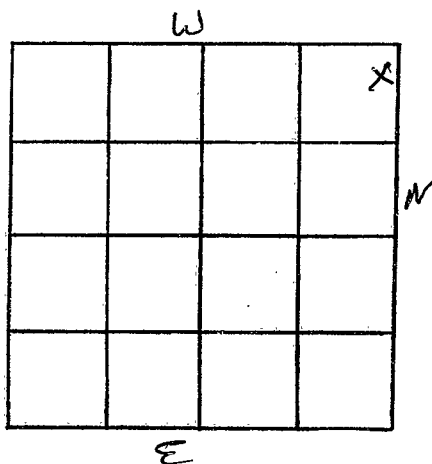

SECTION 35

Please indicate well location X.

ADDITIONAL INFORMATION

If more than one screen,
show locations of each on sketch.