

MISSISSIPPI
BOARD OF WATER COMMISSIONERS
416 North State Street
Jackson, Mississippi 39201

CODED

WATER WELL DRILLERS LOG

TATE
B53
10-10-72

10-10 1972 Harris Bros. Tate
date well completed firm name county well located

LANDOWNER Charlie Moore

description of formations encountered

Rt. 2
Caldwater
(mailing address)

	from	to
top soil	0	20
white clay	20	45
clay sand	45	120
coarse sand	120	140

WELL LOCATION:
sec. 26 T 4 N R. 7 E
2 miles W of Lowman
(distance) (direction) (nearest town)

WELL PURPOSE: home
(home, irrigation, municipal, industrial)

WELL COMPLETION DATA:

- (1) diameter (inches) 4
- (2) total depth (feet) 140
- (3) static water level (feet) 80 below above top of ground.
- (4) casing Plastic, 133'
(material) (depth)
4 if telescope see back.
(size)
- (5) screen 7', 133'
(length) (depth to top)
008, Plastic
(size) (material)
- (6) pump 3/4, 10
(HP) (yield gpm)
elec.
(type power)
- (7) electric log NO
(yes or no)
- (organization running log)
- (8) how well bottom plugged solid


CODED

DRILLERS REMARKS:

MAR 26 1973

If well telescopes please sketch and show depths.

GROUND LEVEL

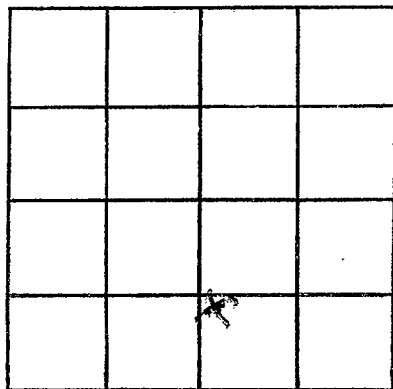

SECTION 26

Please indicate well location X.

ADDITIONAL INFORMATION

If more than one screen,
show locations of each on sketch.