

TATE
B54
10-15-72

MISSISSIPPI
BOARD OF WATER COMMISSIONERS
416 North State Street
Jackson, Mississippi 39201

CODED

WATER WELL DRILLERS LOG

10-15 1972 Harris Bros. Tate
date well completed firm name county well located


LANDOWNER	description of formations encountered	from	to
<u>Undean Davis</u> <u>pt. 3</u>	<u>top soil</u>	<u>0</u>	<u>20</u>
<u>Coldwater</u> (mailing address)	<u>gray clay</u>	<u>20</u>	<u>65</u>
WELL LOCATION: sec. <u>18</u> T. <u>4</u> N. R. <u>7</u> E. <u>1 1/2</u> miles <u>W</u> of <u>Leeline</u> (distance) (direction) (nearest town)	<u>clay + fine sand</u>	<u>65</u>	<u>120</u>
WELL PURPOSE: <u>home</u> (home, irrigation, municipal, industrial)	<u>coarse sand</u>	<u>120</u>	<u>140</u>
WELL COMPLETION DATA: (1) diameter (inches) <u>4</u> (2) total depth (feet) <u>140</u> (3) static water level (feet) <u>100</u> <u>below</u> <u>above</u> top of ground. (4) casing <u>Plastic</u> , <u>133'</u> (material) (depth) <u>4</u> (size) if telescope see back. (5) screen <u>7</u> , <u>133'</u> (length) (depth to top) <u>008</u> , <u>Plastic</u> (size) (material) (6) pump <u>3/4</u> , <u>7</u> (HP) (yield gpm) <u>elec.</u> (type power) (7) electric log <u>no</u> (yes or no) (organization running log) (8) how well bottom plugged <u>solid</u>			

CODED

DRILLERS REMARKS:

If well telescopes please
sketch and show depths.

GROUND LEVEL

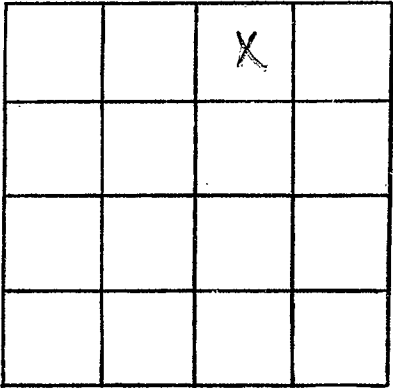

SECTION 18

Please indicate well location X.

ADDITIONAL INFORMATION

If more than one screen,
show locations of each on sketch.