

TATE
B55
1-23-73

MISSISSIPPI
BOARD OF WATER COMMISSIONERS
416 North State Street
Jackson, Mississippi 39201

CODED

WATER WELL DRILLERS LOG

Tate
Lumbert

1-23-1973 date well completed Bob Smith firm name Tate county well located

LANDOWNER:
Van Oansuy
Arkaboth miss
(mailing address)

description of formations encountered	from	to
clay silt		10
gravel	10	32
Red sand	32	38
STREAKS OF white sand + white clay		
70% clay	38	110
white sand	110	170

WELL LOCATION:
sec. 31 T 4 N R 8 E
1 1/2 miles East of Arkaboth
(distance) (direction) (nearest town)

WELL PURPOSE: Home
(home, irrigation, municipal, industrial)


- WELL COMPLETION DATA:
- (1) diameter (inches) 4
 - (2) total depth (feet) 170
 - (3) static water level (feet) 96 below top of ground.
 - (4) casing Plastic 17.0 (material) (depth)
(size) If telescope see back.
 - (5) screen 20 150 (length) (depth to top)
4 Plastic (size) (material)
 - (6) pump 1/2 10 (HP) (yield gpm)
Elec. (type power)
 - (7) electric log no (yes or no)
(organization running log)
 - (8) how well bottom plugged plugged

CODED

DRILLERS REMARKS:

If well telescopes please sketch and show depths.

GROUND LEVEL

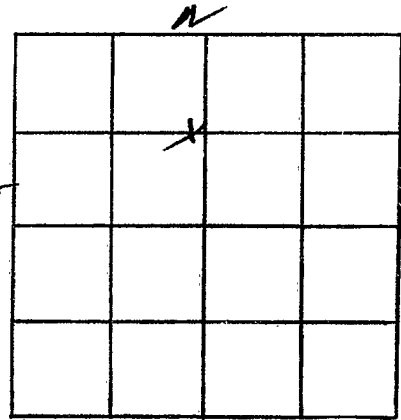

SECTION 31

Please indicate well location X.

ADDITIONAL INFORMATION

If more than one screen, show locations of each on sketch.