

LATE
B 57
7-19-73

MISSISSIPPI
BOARD OF WATER COMMISSIONERS
416 North State Street
Jackson, Mississippi 39201

CODED

WATER WELL DRILLERS LOG

7-19-1973 date well completed Bob Hill firm name Jato county well located

LANDOWNER:	description of formations encountered	from	to
<i>De yorio</i>		<i>clay</i>	<i>0</i>
<i>Coldwater - miss.</i> (mailing address)	<i>gravel</i>	<i>20</i>	<i>40</i>
WELL LOCATION: sec. <i>3</i> T. <i>4</i> N. R. <i>8</i> E <i>6</i> miles <i>West</i> of <i>Coldwater</i> (distance) (direction) (nearest town)	<i>white sand</i>	<i>40</i>	<i>125</i>
WELL PURPOSE: <i>Home</i> (home, irrigation, municipal, industrial)			
WELL COMPLETION DATA:			
(1) diameter (inches) <i>4</i>			
(2) total depth (feet) <i>125</i>			
(3) static water level (feet) <i>24</i> below top of ground.			
(4) casing <i>Plastic</i> <i>125</i> (material) (depth)			
(size) If telescope see back.			
(5) screen <i>20</i> <i>105</i> (length) (depth to top)			
<i>4</i> <i>Plastic</i> (size) (material)			
(6) pump <i>1/2</i> <i>10</i> (HP) (yield gpm)			
<i>E lei</i> (type power)			
(7) electric log <i>no</i> (yes or no)			
(organization running log)			
(8) how well bottom plugged <i>plugged</i>			
DRILLERS REMARKS:			


CODED

SEP 27 1973

MISS. B. & I.
MEMBER

If well telescopes please sketch and show depths.

GROUND LEVEL

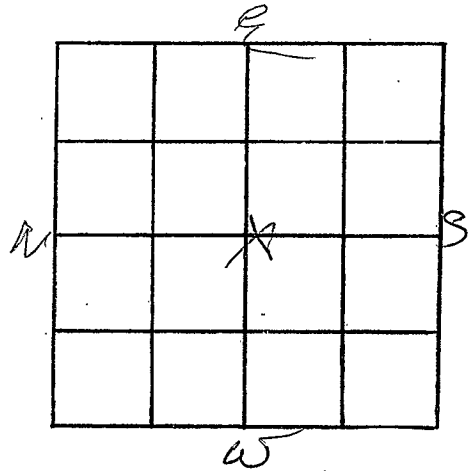

SECTION 31

Please indicate well location X.

ADDITIONAL INFORMATION

If more than one screen, show locations of each on sketch.