

TATE
B 58
10-15-73

MISSISSIPPI
BOARD OF WATER COMMISSIONERS
416 North State Street
Jackson, Mississippi 39201

CODED

WATER WELL DRILLERS LOG

10-15 date well completed 1973 Harris Bros firm name Tate county well located

LANDOWNER: Bert M. Marsh
Rt. 4
Coldwater
(mailing address)

description of formations encountered	from	to
top soil	0	20
sand	20	40
clay sand	40	125
coarse sand	125	140

WELL LOCATION:
sec. 36 T. 4 N. R. 7 E
1/2 miles W of Brown
(distance) (direction) (nearest town)

WELL PURPOSE: residential
(home, irrigation, municipal, industrial)

- WELL COMPLETION DATA:
- (1) diameter (inches) 4
 - (2) total depth (feet) 140
 - (3) static water level (feet) 80 ^{below} above top of ground.
 - (4) casing Plastic, 133,
(material) (depth)
4 if telescope see back.
(size)
 - (5) screen 7, 133
(length) (depth to top)
008, Plastic
(size) (material)
 - (6) pump 3/4, 10
(HP) (yield gpm)
elec.
(type power)
 - (7) electric log no
(yes or no)
 - (organization running log)
 - (8) how well bottom plugged solid

CODED


OCT 20 1973

DRILLERS REMARKS:

MISS. BD. OF
WATER COM.

If well telescopes please sketch and show depths.

GROUND LEVEL

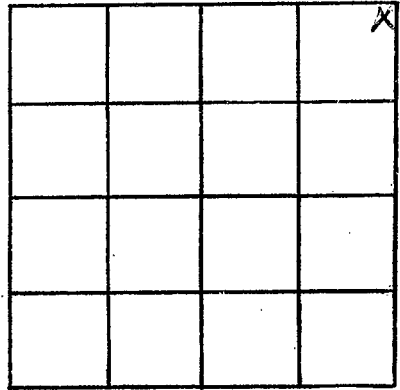

SECTION 36

Please indicate well location X.

ADDITIONAL INFORMATION

If more than one screen,
show locations of each on sketch.