

TATE
B 59
10-1-73

MISSISSIPPI
BOARD OF WATER COMMISSIONERS
416 North State Street
Jackson, Mississippi 39201

CODED

WATER WELL DRILLERS LOG

10-1 1973 Harris Bros. Tate
date well completed firm name county well located


LANDOWNER	description of formations encountered	from	to
Douglas Johnson Pt. 3 Coldwater (mailing address)	top soil	0	15
	red sand	15	45
	sand & clay	45	130
	Coarse sand	130	150
<p>WELL LOCATION: sec 27 T 4 N R 7 E 2 miles E of Coldwater (distance) (direction) (nearest town)</p>			
<p>WELL PURPOSE: home (home, irrigation, municipal, industrial)</p>			
<p>WELL COMPLETION DATA:</p>			
(1) diameter (inches) 4			
(2) total depth (feet) 150			
(3) static water level (feet) 80 ^{below} _{above} top of ground.			
(4) casing Plastic, 136 (material) (depth) 4 (size) If telescope see back.			
(5) screen 14, 136 (length) (depth to top) 008, Plastic (size) (material)			
(6) pump 3/4, 10 (HP) (yield gpm) elec. (type power)			
(7) electric log no (yes or no)			
(organization running log)			
(8) how well bottom plugged solid			
DRILLERS REMARKS:			

CODED

APR 28 1973

If well telescopes please sketch and show depths.

GROUND LEVEL

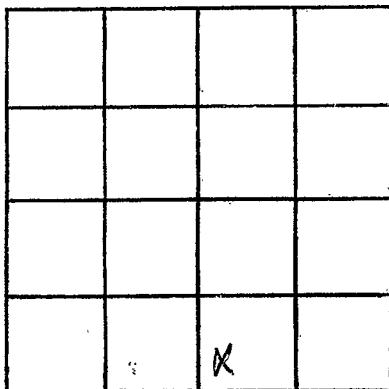

SECTION 27

Please indicate well location X.

ADDITIONAL INFORMATION

If more than one screen,
show locations of each on sketch.