

TATE
B61
5-9-73

MISSISSIPPI
BOARD OF WATER COMMISSIONERS
416 North State Street
Jackson, Mississippi 39201

CODED

WATER WELL DRILLERS LOG

5-9 date well completed 73 Harris Bros. firm name Tate county well located

LANDOWNER: Leroy Cochran
Rt. 4
Coldwater
(mailing address)

description of formations encountered	from	to
<u>top soil</u>	<u>0</u>	<u>15</u>
<u>fine sand+clay</u>	<u>15</u>	<u>85</u>
<u>Coarse w. sand</u>	<u>85</u>	<u>100</u>

WELL LOCATION:
sec 27 T. 4 N R. 7 E
3 1/2 miles S of Coldwater
(distance) (direction) (nearest town)

WELL PURPOSE: home
(home, irrigation, municipal, industrial)

- WELL COMPLETION DATA:
- (1) diameter (inches) 4
 - (2) total depth (feet) 100
 - (3) static water level (feet) 60 ^{below} above top of ground.
 - (4) casing Plastic, 93,
(material) (depth)
4 if telescope see back.
(size)
 - (5) screen 7, 93
(length) (depth to top)
 - 008, Plastic
(size) (material)
 - (6) pump 3/4, 10
(HP) (yield gpm)
 - elec.
(type power)
 - (7) electric log no
(yes or no)
 - (organization running log)
 - (8) how well bottom plugged solid

CODED


OCT 20 1973

MISS. Bd. of
Water Comm.

DRILLERS REMARKS:

If well telescopes please sketch and show depths.

GROUND LEVEL

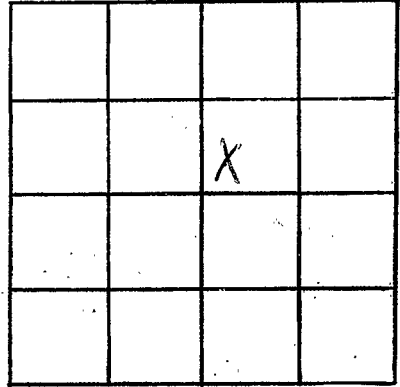

SECTION 27

Please indicate well location X.

ADDITIONAL INFORMATION

If more than one screen, show locations of each on sketch.