

TATE
B62
6-5-73

MISSISSIPPI
BOARD OF WATER COMMISSIONERS
416 North State Street
Jackson, Mississippi 39201

WATER WELL DRILLERS LOG

6-5 1973 Harris Bros. Tate
date well completed firm name county well located

LANDOWNER: W. Trent Hall
pt. 2
Coldwater
(mailing address)

description of formations encountered	from	to
top soil	0	20
red sand	20	45
fine sand + clay	45	125
coarse sand	125	150

WELL LOCATION:
sec. 35 T 4 N R 7 E
4 miles E of Coldwater
(distance) (direction) (nearest town)

WELL PURPOSE: home
(home, irrigation, municipal, industrial)

- WELL COMPLETION DATA:
- (1) diameter (inches) 4
 - (2) total depth (feet) 150
 - (3) static water level (feet) 80 ^{below}/_{above} top of ground.
 - (4) casing Plastic, 136,
(material) (depth)
4 If telescope see back.
(size)
 - (5) screen 14, 136
(length) (depth to top)
008 Plastic
(size) (material)
 - (6) pump 3/4, 7
(HP) (yield gpm)
elec.
(type power)
 - (7) electric log NO
(yes or no)
 - (organization running log)
 - (8) how well bottom plugged solid

LOGGED


NOV 28 1973

DRILLERS REMARKS:

MRS. M. O. WOOD

If well telescopes please sketch and show depths.

GROUND LEVEL

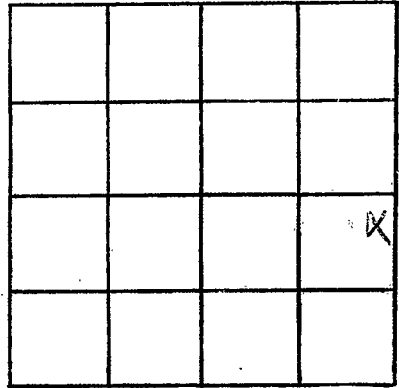

SECTION 35

Please indicate well location X.

ADDITIONAL INFORMATION

If more than one screen,
show locations of each on sketch.