

TATE
B 63
12-23-71

MISSISSIPPI
 BOARD OF WATER COMMISSIONERS
 416 North State Street
 Jackson, Mississippi 39201
WATER WELL DRILLERS LOG

12-23 1971 JIM-REVIN TATE
 date well completed firm name county well located

LANDOWNER: JEWEL-BETTS
RT. 1-
COLDWATER, MISS
 (mailing address)

description of formations encountered	from	to
<u>D.M.S</u>	<u>0</u>	<u>12</u>
<u>GRAVEL</u>	<u>17</u>	<u>52</u>
<u>CLAY-</u>	<u>55</u>	<u>131</u>
<u>SAND</u>	<u>131</u>	<u>151</u>

WELL LOCATION:
 sec 33 T 4 N R 8 E
 S W
4 miles WEST of COLDWATER
 (distance) (direction) (nearest town)

WELL PURPOSE: HOME
 (home, irrigation, municipal, industrial)

- WELL COMPLETION DATA:
- (1) diameter (inches) 2 IN
 - (2) total depth (feet) 151 FT
 - (3) static water level (feet) 112 below above ground.
 - (4) casing CMN 1147
 (material) (depth)
2 1/4 if telescope see back.
 (size)
 - (5) screen 48 IN 147
 (length) (depth to top)
1 1/4 STAINLESS STEEL
 (size) (material)
 - (6) pump 3 1/2 HP 10
 (HP) (yield gpm)
FLRC
 (type power)
 - (7) electric log NO
 (yes or no)
 (organization running log)
 - (8) how well bottom plugged OPEN

JAN 10 1972

DRILLERS REMARKS:

MISS. BD. OF
 WATER COMMISSIONERS

If well telescopes please sketch and show depths.

GROUND LEVEL

2 in

GALV

143'


1 1/4"

GALV
4'

1 1/4"

STAINLESS STEEL

STRAINER
4'

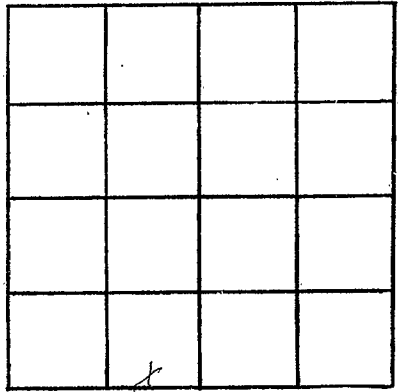

SECTION 33

Please indicate well location X.

ADDITIONAL INFORMATION

If more than one screen,
show locations of each on sketch.