

TATE
 A32B64
 6-20-73

MISSISSIPPI
 BOARD OF WATER COMMISSIONERS
 416 North State Street
 Jackson, Mississippi 39201

CODED

WATER WELL DRILLERS LOG

6-20-1973 date well completed Bob Hill firm name Tate county well located

LANDOWNER:	description of formations encountered	from	to
J. A. Love Coldwater, Miss. (mailing address)			
	Red clay	12	20
	gravel	20	70
	sand + gravel	70	115
	blue clay	135	178
	white sand	178	195

WELL LOCATION:
 sec. 31 T. 4 N. R. 8 E.
 6 miles west of Coldwater
 (distance) (direction) (nearest town)

WELL PURPOSE: Home
 (home, irrigation, municipal, industrial)

WELL COMPLETION DATA:

(1) diameter (inches) 4

(2) total depth (feet) 195

(3) static water level (feet) 90 below above top of ground.

(4) casing Plastic 195
 (material) (depth)
 (size) if telescope see back.

(5) screen 20 175
 (length) (depth to top)
 4 Plastic
 (size) (material)

(6) pump 1/2 10
 (HP) (yield gpm)
 Electric
 (type power)

(7) electric log no
 (yes or no)
 (organization running log)

(8) how well bottom plugged plugged

CODED


DRILLERS REMARKS:

SEP 27 1973

MISS. Bd. of WATER COMMISSIONERS

If well telescopes please sketch and show depths.

GROUND LEVEL

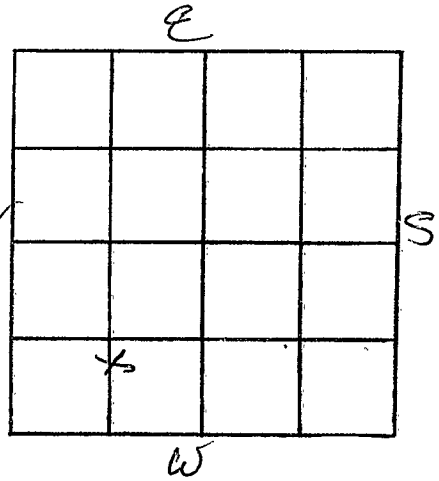

SECTION 31

Please indicate well location X.

ADDITIONAL INFORMATION

If more than one screen,
show locations of each on sketch.