

TATE  
B68  
8-20-74

MISSISSIPPI  
BOARD OF WATER COMMISSIONERS  
416 North State Street  
Jackson, Mississippi 39201

CODED

WATER WELL DRILLERS LOG

Tate  
Desoto


Aug. 20, 1974 Bob Smith + Son  
date well completed firm name county well located

LANDOWNER: <u>David Poenders</u>	description of formations encountered	from	to
<u>Woods Dr,</u>	<u>dirt + sand</u>	<u>0</u>	<u>20</u>
<u>Caldwater, MS</u>	<u>clay + sand</u>	<u>20</u>	<u>40</u>
(mailing address)	<u>fine sand</u>	<u>40</u>	<u>90</u>
	<u>white coarse sand</u>	<u>90</u>	<u>115</u>
<b>WELL LOCATION:</b>			
sec <u>36</u> T <u>5</u> N R <u>8</u> E			
<u>2</u> miles <u>W</u> of <u>Caldwater</u>			
(distance) (direction) (nearest town)			
<b>WELL PURPOSE:</b> <u>none</u>			
(home, irrigation, municipal, industrial)			
<b>WELL COMPLETION DATA:</b>			
(1) diameter (inches) <u>4"</u>			
(2) total depth (feet) <u>115'</u>			
(3) static water level (feet) <u>39'</u> <u>below</u> top of ground.			
(4) casing <u>plastic, 115'</u> (material) (depth)			
_____ If telescope see back. (size)			
(5) screen <u>10'</u> , <u>105'</u> (length) (depth to top)			
<u>4"</u> , <u>plastic</u> (size) (material)			
(6) pump <u>1/2</u> , <u>10'</u> (HP) (yield gpm)			
<u>electric</u> (type power)			
(7) electric log <u>no</u> (yes or no)			
_____ (organization running log)			
(8) how well bottom plugged <u>plugged</u>			
<b>DRILLERS REMARKS:</b>			

RECEIVED  
AUG 26 1974  
MISS BE OF WATER COM

If well telescopes please sketch and show depths.

GROUND LEVEL

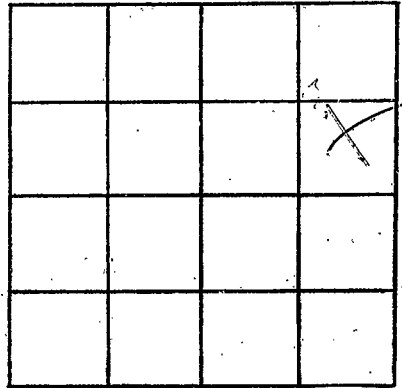

SECTION 36

Please indicate well location X.

ADDITIONAL INFORMATION

If more than one screen, show locations of each on sketch.