

TATE
B 69
8-31-74

MISSISSIPPI
BOARD OF WATER COMMISSIONERS
416 North State Street
Jackson, Mississippi 39201

CODED

WATER WELL DRILLERS LOG

8-31-74 date well completed W.A. Mason firm name Tate county well located

LANDOWNER:	description of formations encountered	from	to
Ed Parish Memphis Tenn. (mailing address)			
WELL LOCATION:	gravel	12	18
sec. 324 N R 8 E 4 1/2 miles West of Collierville (distance) (direction) (nearest town)	arkhite clay	18	40
WELL PURPOSE: Home (home, irrigation, municipal, industrial)	arkhite sand	40	110
WELL COMPLETION DATA:			
(1) diameter (inches) 4"			
(2) total depth (feet) 110'			
(3) static water level (feet) 52' below top of ground.			
(4) casing Plaster 100' (material) (depth) 4" if telescope see back. (size)			
(5) screen 10' 100' (length) (depth to top) 4" Plaster (size) (material)			
(6) pump 1/2 10 (HP) (yield gpm) electric (type power)			
(7) electric log No (yes or no)			
(organization running log)			
(8) how well bottom plugged Cap			
DRILLERS REMARKS:			

CODED


RECORDED
INDEXED

DEC 27 1974

MISS. DD. OF WATER COMMISSIONERS

If well telescopes please sketch and show depths.

GROUND LEVEL

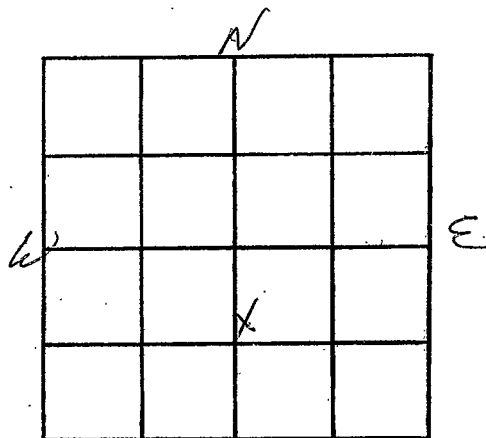

S
SECTION 32

Please indicate well location X.

ADDITIONAL INFORMATION

If more than one screen,
show locations of each on sketch.