

LATE
B 70
2-27-74

MISSISSIPPI
 BOARD OF WATER COMMISSIONERS
 416 North State Street
 Jackson, Mississippi 39201

CODED

WATER WELL DRILLERS LOG

2-27- 1974 W.R. Mason Jate
 date well completed firm name county well located


LANDOWNER:	description of formations encountered	from	to
<u>William E. Butler</u>			
<u>Memphis Tenn.</u> (mailing address)	<u>Red sand</u>	<u>12</u>	<u>20</u>
WELL LOCATION:	<u>gravel</u>	<u>20</u>	<u>30</u>
sec. <u>32</u> T. <u>4</u> N. R. <u>8</u> E.	<u>ash to clay</u>	<u>30</u>	<u>50</u>
(S) (W)	<u>white sand</u>	<u>50</u>	<u>100</u>
<u>4 1/2</u> miles <u>west</u> of <u>Caldwell</u>			
(distance) (direction) (nearest town)			
WELL PURPOSE: <u>Home</u> (home, irrigation, municipal, industrial)			
WELL COMPLETION DATA:			
(1) diameter (inches) <u>4"</u>			
(2) total depth (feet) <u>100</u>			
(3) static water level (feet) <u>45</u> below above top of ground.			
(4) casing <u>Plastic</u> , <u>90</u> (material) (depth)			
<u>4"</u> (size) If telescope see back.			
(5) screen <u>10'</u> , <u>90'</u> (length) (depth to top)			
<u>4"</u> , <u>Plastic</u> (size) (material)			
(6) pump <u>1/3</u> , <u>7</u> (HP) (yield gpm)			
<u>Electric</u> (type power)			
(7) electric log <u>No</u> (yes or no)			
(organization running log)			
(8) how well bottom plugged <u>cap</u>			
DRILLERS REMARKS:			

CODED

DEC 27 1974

If well telescopes please sketch and show depths.

GROUND LEVEL

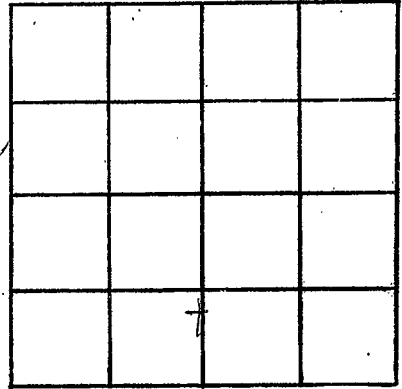

SECTION 5 32

Please indicate well location X.

ADDITIONAL INFORMATION

If more than one screen,
show locations of each on sketch.