

Chas. J. Johnson
12-20-74
OK

LATE
B 71
11-21-72

MISSISSIPPI
BOARD OF WATER COMMISSIONERS
416 North State Street
Jackson, Mississippi 39201

CODED

WATER WELL DRILLERS LOG


Nov. 21, 1972 *Bob Smith Well Drilling* *Late*
date well completed firm name county well located

LANDOWNER: <i>Charles Johnson</i>	description of formations encountered	from	to
<i>Caldwater, Miss.</i> (mailing address)	<i>Red clay</i>	0	10
WELL LOCATION: sec. <u>33</u> T. <u>4</u> N. R. <u>7</u> E. <u>2</u> miles <u>West</u> of <u>Caldwater</u> (distance) (direction) (nearest town)	<i>Sand & clay</i>	10	60
WELL PURPOSE: <i>home</i> (home, irrigation, municipal, industrial)	<i>Course sand</i>	60	103
WELL COMPLETION DATA: (1) diameter (inches) <u>4</u> (2) total depth (feet) <u>103'</u> (3) static water level (feet) <u>18</u> below/above top of ground. (4) casing <u>Plastic</u> , <u>103'</u> (material) (depth) (size) If telescope see back. (5) screen <u>20'</u> , <u>83'</u> (length) (depth to top) <u>4</u> , <u>Plastic</u> (size) (material) (6) pump <u>1/3</u> , <u>10</u> (HP) (yield gpm) <u>Elec.</u> (type power) (7) electric log <u>no</u> (yes or no) (organization running log) (8) how well bottom plugged <i>plugged</i>	CODED		
DRILLERS REMARKS:			

RECEIVED
DEC 19 1974

If well telescopes please sketch and show depths.

GROUND LEVEL

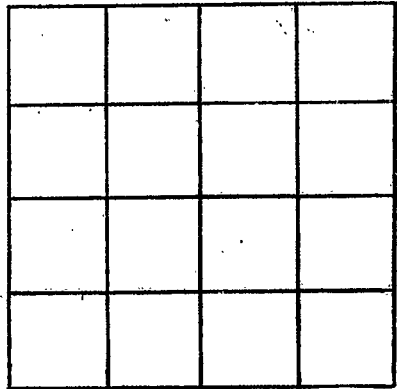

SECTION _____

Please indicate well location X.

ADDITIONAL INFORMATION

If more than one screen, show locations of each on sketch.