

TATE
B 72
1-29-75

MISSISSIPPI
BOARD OF WATER COMMISSIONERS
416 North State Street
Jackson, Mississippi 39201

CODED

WATER WELL DRILLERS LOG

Jan. 29 1975 B. B. Cole & Bill Drilling Jate
date well completed firm name county well located


LANDOWNER: <u>B. B. Cole</u> <u>Rt. 3</u>	description of formations encountered	from	to
<u>Coldwater, Miss.</u> (mailing address)	<u>sand & top soil</u>	<u>0'</u>	<u>20'</u>
WELL LOCATION: sec. <u>28</u> T <u>4</u> N R <u>7</u> E <u>(S)</u> <u>(W)</u>	<u>clay</u>	<u>20'</u>	<u>60'</u>
<u>3</u> miles <u>east</u> of <u>Coldwater</u> (distance) (direction) (nearest town)	<u>sand</u>	<u>60'</u>	<u>100'</u>
WELL PURPOSE: <u>(home)</u> irrigation, municipal, industrial	CODED		
WELL COMPLETION DATA:			
(1) diameter (inches) <u>4"</u>			
(2) total depth (feet) <u>100'</u>			
(3) static water level (feet) <u>18'</u> below top of ground.			
(4) casing <u>plastic</u> , <u>100'</u> (material) (depth)			
_____ If telescope see back. (size)			
(5) screen <u>4"</u> <u>90'</u> (length) (depth to top)			
<u>4"</u> <u>plastic</u> (size) (material)			
(6) pump <u>1</u> <u>25</u> (HP) (yield gpm)			
<u>Electric</u> (type power)			
(7) electric log <u>no</u> (yes or no)			
_____ (organization running log)			
(8) how well bottom plugged <u>plugged</u>			
DRILLERS REMARKS:			

RECEIVED
APR - 2 1975

MISS. BD. OF WATER COMM.

If well telescopes please sketch and show depths.

GROUND LEVEL

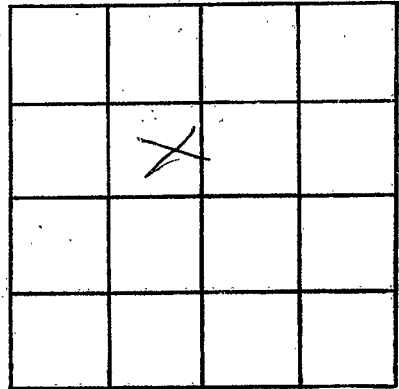

SECTION _____

Please indicate well location X.

ADDITIONAL INFORMATION

If more than one screen, show locations of each on sketch.