

IATE
B73
1-22-75

MISSISSIPPI
 BOARD OF WATER COMMISSIONERS
 416 North State Street
 Jackson, Mississippi 39201

CODED

WATER WELL DRILLERS LOG

Jan. 22, 1975 Bob Smith Well Drilling Iate
 date well completed firm name county well located

LANDOWNER: Mr. Francis Lewis
Rt 2 Box 184
Coldwater, Miss.
 (mailing address)

description of formations encountered	from	to
	<u>top soil & red sand</u>	<u>0'</u>
<u>white clay</u>	<u>30'</u>	<u>45'</u>
<u>fine sand</u>	<u>45'</u>	<u>80'</u>
<u>course sand</u>	<u>80'</u>	<u>126'</u>

WELL LOCATION:
 sec 36 T 4 N R 7 E
 (S) (W)
6 miles east of Coldwater
 (distance) (direction) (nearest town)

WELL PURPOSE:
 home irrigation, municipal, industrial)

- WELL COMPLETION DATA:
- diameter (inches) 4"
 - total depth (feet) 126'
 - static water level (feet) 60 below above top of ground.
 - casing plastic, 126'
 (material) (depth)
 (size) if telescope see back.
 - screen 10', 116'
 (length) (depth to top)
4", plastic
 (size) (material)
 - pump 1/2, 8
 (HP) (yield gpm)
electric
 (type power)
 - electric log no
 (yes or no)
 (organization running log)
 - how well bottom plugged plugged

CODED


RECEIVED

APR - 2 1975

DRILLERS REMARKS:

If well telescopes please sketch and show depths.

GROUND LEVEL

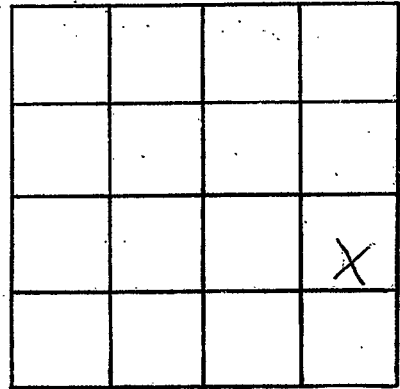

SECTION _____

Please indicate well location X.

ADDITIONAL INFORMATION

If more than one screen,
show locations of each on sketch.