

Jate
B 74
6-7-75

MISSISSIPPI
BOARD OF WATER COMMISSIONERS
416 North State Street
Jackson, Mississippi 39201

CODED

WATER WELL DRILLERS LOG

6-17-75 date well completed 1975 Shanks Well Co. firm name Jate county well located


LANDOWNER:	description of formations encountered	from	to
E. U. Thompson - Route 1, Coldwater, Miss (mailing address)	Red Clay + Shamel	0	30
	Black Clay	30	75
WELL LOCATION: sec. 31 T. 4 N. R. 8 E. 15E S miles E of Arabon (distance) (direction) (nearest town)	Black Clay + white clay	75	90
	white clay + sand	90	120
WELL PURPOSE: <i>drinking</i> (home, irrigation, municipal, industrial)	white sand	120	135
WELL COMPLETION DATA:	white sand + black clay	135	180
(1) diameter (inches) <i>4 1/2</i>	white sand	180	205
(2) total depth (feet) <i>205</i>			
(3) static water level (feet) <i>150</i> below top of ground.			
(4) casing <i>plastic 205</i> (material) (depth)			
(size) if telescope see back.			
(5) screen <i>4 1/2 x 201</i> (length) (depth to top)			
<i>4 1/2</i> <i>shamel</i> (size) (material)			
(6) pump <i>1/2</i> <i>10</i> (HP) (yield gpm)			
<i>Electric 230</i> (type power)			
(7) electric log <i>no</i> (yes or no)			
(organization running log)			
(8) how well bottom plugged <i>cap</i>			
DRILLERS REMARKS:			

JUL 21 1975

MISS. BD. OF WATER COMMISSIONERS

If well telescopes please sketch and show depths.

GROUND LEVEL

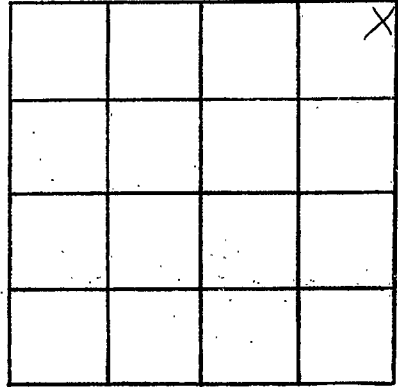

SECTION 31

Please indicate well location X.

ADDITIONAL INFORMATION

Lined area for additional information.

If more than one screen, show locations of each on sketch.