

MISSISSIPPI DEPARTMENT OF ENVIRONMENTAL QUALITY

Office of Land and Water Resources

P. O. Box 10631
Jackson, MS 39289-0631
WATER WELL DRILLERS LOG

COUNTY WELL LOCATED
MAE

WELL NUMBER 586 CODED

B-84

DATE WELL COMPLETED
10-5-02

PERMIT NUMBER

NAME OF DRILLING FIRM
SMITH WELL DRILLING & SERVICE

NAME & MAILING ADDRESS OF LANDOWNER
DAVIS
1031 COLDEN AVE COLWATER

Latitude:
Longitude:

WELL LOCATION: SEC C-33 TOWNSHIP T-4 RANGE R-7

DISTANCE 2 Miles DIRECTION E of NEAREST TOWN COLWATER

OTHER LANDMARK

WELL PURPOSE: Home, Irrigation, Municipal, Industrial, Fish Pond, etc.
NONE

PUMP DATA

PUMP TYPE (Circle One):
 Submersible, Turbine, Jet, Flowing Well,
Other (Describe)

POWER TYPE (Circle One):
 Electric, Tractor, Diesel, Gasoline, Butane,
Other (Describe) H/P 34

DESCRIPTION OF FORMATIONS ENCOUNTERED	FROM	TO
<u>TOP SOIL</u>	<u>0</u>	<u>10</u>
<u>SAND + GRAVEL</u>	<u>10</u>	<u>30</u>
<u>WHITE + YELLOW CLAY</u>	<u>30</u>	<u>60</u>
<u>WHITE SAND + CLAY</u>	<u>60</u>	<u>100</u>
<u>WHITE SAND</u>	<u>100</u>	<u>136</u>

RECEIVED
OCT 24 2002
BY: OLWR

Top of Lap Pipe or Reduction in Casing

FEET IF TELESCOPED OR MORE THAN ONE SCREEN: USE BACK PAGE

WELL DATA

Well Depth <u>136</u>	Casing Diameter (In.) <u>4"</u>	Casing Length (Ft.) <u>126</u>
Type of Casing <u>PVC</u>	Hole Depth <u>136</u>	Depth to Static Water Level <u>70</u>

TYPE OF COMPLETION: (Circle One or More):
 Gravel Packed, Underreamed, Telescoped,
 Natural Development, Open Hole, Other
(Describe) WASHED SAND

WELL GROUTED TO A DEPTH OF 10 FEET
Type Grout (circle one): Cement, Bentonite, or Mix

SCREEN DATA

Diameter - Inches <u>4"</u>	Length - Feet <u>10</u>	Slot Size - Inches <u>14 TAPES</u>
Screen Type <u>PVC</u>	Depth to Bottom - Feet <u>136</u>	

I certify that the well was drilled, constructed and completed in accordance with all applicable Requirements of the Mississippi Department of Environmental Quality and/or the Mississippi Department of Health regulations and state laws.


[Signature]
Signature of Licensed Driller and License No. 0645

10-19-02
Date

Additional Information Required On Back

If well telescopes please sketch and show depths.

GROUND LEVEL

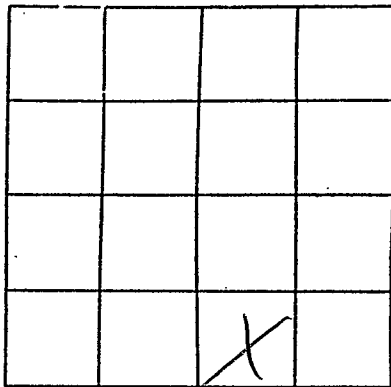

SECTION C-33

Please indicate well location X.

Pump Capacity (GPM)	No. of Stages	Setting Depth	
<u>12</u>	<u>11</u>	<u>80</u>	FT.

PUMP TEST

Well yielded 15 GPM with
a drawdown of 3 ft.
after 1 hours of pumping

LOG DATA

TYPE OF LOG RUN (Circle One): _____ No Log Run,
Electric, Gamma Ray, Density, Sonic, Neutron,
Other (Describe) _____

Name of Organization Running Log

GEOLOGIC DATA (Office Use Only)

Surface Elev.	Geologic Unit	Unit Thickness	Depth to Top
Subs. SWL	Date	Analysis	Aquifer Test

Driller's Remarks

If more than one screen,
show location of each on sketch.