

State Well Report

Part 1

Mississippi Department of Environmental Quality
Office of Land and Water Resources
P.O. Box 10631
Jackson, MS 39289-0631
(601)961-5210
(601)354-6938 (fax)

For Office Use Only:

Aquifer: _____
Well #: B-112
L. S. Elevation: _____
E-log #: _____

County: TATE 137
Permit #: _____
Driller: Bob Smith
Date drilling completed: 9-23-04

Smith Well Drilling and Service
State Law requires that this report be prepared by the driller in detail and filed with the Department within 30 days of completion of drilling of the well.

Well Owner Information		Well Location	
Owner Name: <u>KATE HULLAND</u>	Latitude: _____ Longitude: _____	Method of Lat/Long (circle one): Conventional Survey, USGS quad, Hand-held GPS, Survey-grade GPS	
Mailing Address: <u>710 SCOTT RD</u>	USGS quad, Hand-held GPS, Survey-grade GPS	1/4 _____ 1/4 Sec <u>C-35</u> Twn <u>T-45</u> Rng <u>R-7W</u>	
<u>CARDWELL</u>	Distance _____ Direction _____ Nearest Town _____	Distance <u>4</u> Miles <u>E</u> of <u>CARDWELL</u>	
City _____ State _____ Zip Code _____	Telephone No <u>601 941-6420</u>		

Well Data

Purpose of Well (circle one): Home Industrial Public Supply Irrigation Fish Culture Other: _____

Date well drilling started: 9-23-04 Date well drilling completed: 9-23-04

If flowing, method of flow regulation: Valve _____ Other (describe) _____

Static Water Level: 98' feet above or below (circle one) land surface Date measured: 9-23-04

Method of Measurement (circle one): steel tape electric tape air line other: _____

Hole depth: 170 Well depth: 170 Well grouted to a depth of 10 feet

Type of grout (circle one): Cement Bentonite Mix

Casing length: 160 feet Casing diameter: 4 inches Type of casing: PVC

Screen length: 10 feet Screen diameter: 4 inches Type of screen: PVC

Screen slot size: 1/4 THOUS inches Setting depth: From 160 feet to 170 feet

Type of completion (circle all applicable): Gravel packed Underreamed Telescoped Open hole Natural Development

Other (describe): WASHED SAND

Top of lap pipe or reduction in casing: _____ feet. If telescoped or more than one screen, describe on back of page

Logs run (circle all applicable): No log run Electric Gamma Ray Density Sonic Neutron Other: _____

Name of organization running log(s): _____

I certify that the well was drilled, constructed, and completed in accordance with all applicable requirements of the Mississippi Department of Environmental Quality and/or the Mississippi Department of Health regulations and state laws.

ROBERT C SMITH 0-645 [Signature]
Print Name of Water Well Contractor and License No. Signature of Water Well Contractor

RECEIVED
OCT 07 2004
BY: OLWR

If well telescopes please sketch below and show depths.

B-112


Ground Level

Description of Formations Encountered	From	To
TOP SOIL	0	3
RED-YELLOW CLAY	3	40
WHITE CLAY	40	70
GRAY CLAY	70	90
WHITE SAND & CLAY	90	140
WHITE SAND	140	170

If more than one screen, show location of each on sketch

Sketch the property layout and include the following: 1) the well location; 2) any permanent structures on the property that aid in locating the well; 3) any roads, power lines, or other items that may aid in locating the property and the well; 4) indicate direction.

RECEIVED
OCT 07 2004
BY: OLWR

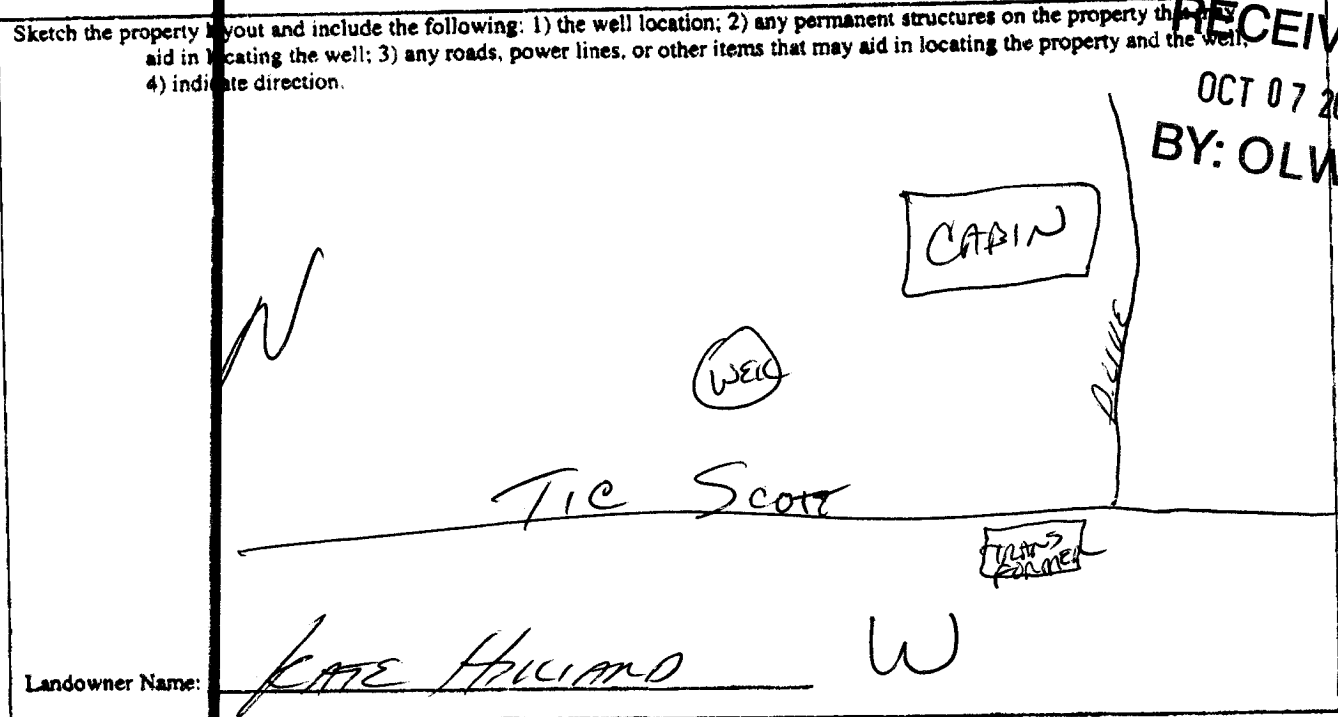

Landowner Name:

KATE HULLIAND

W

[Handwritten Signature]
Signature of Water Well Contractor

STATE WELL REPORT

Part 2

Pump Installer's Completion Report
 Mississippi Department of Environmental Quality
 Office of Land and Water Resources
 P.O. Box 10631
 Jackson, MS 39289-0631
 (601)961-5210
 (601)354-6938 (fax)

For Office Use Only:

Aquifer: _____

Well #: B-112

Elevation: _____

County: TATE
 Permit #: _____
 Driller: BOB SMITH
 Date completed: 9-23-04

This report should be prepared by the pump installer in detail and filed with the Department within 30 days of the installation of pump.

Well Owner Information	Well Location
Owner Name: <u>KATE HUIARD</u>	Latitude: _____ Longitude: _____
Mailing Address: <u>718 SOUTH</u>	Method of Lat/Long (circle one): Conventional Survey,
<u>COLUMBIA</u>	USGS quad. Hand-held GPS, Survey-grade GPS
<u>MS. 38618</u>	_____ 1/4 _____ 1/4 Sec <u>C-35</u> Twn <u>T-45</u> Rng <u>R-2W</u>
City: _____ State: _____ Zip Code: _____	Distance Direction Nearest Town
Telephone No: <u>(601) 941-6420</u>	<u>4</u> Miles <u>E</u> of <u>COLUMBIA</u>

Pump Type Circle one	Power Type Circle one
Air Lift Jet: <u>Submersible</u>	Diesel Engine Gasoline Engine Natural Gas
Bucket Piston Turbine	<u>Electric Motor</u> Hand Tractor PTO
Centrifugal Rotary Flowing Well	Windmill Other (specify): _____
Other (specify): _____	Horse Power Rating of Motor: _____
Date Pump Installed: <u>9-23-04</u>	Setting Depth: <u>120</u> feet
Rated Pump Capacity: <u>12</u> Gallons Per Minute	Number of Stages: <u>12</u>

RECEIVED
 OCT 07 2004
 BY: OLWR

Pump Test Data	Method of Measuring Water Level Circle one
Date Well Tested: <u>9-23-04</u>	Air Line <u>Electric Measuring Line</u> Steel Tape
Static Water Level (A): <u>98</u> Feet Below Land Surface	Other (specify): _____
Pumping Water Level (B): <u>104</u> Feet Below Land Surface	For flowing well, measured shut in head: _____ feet
Drawdown [(B) - (A)]: <u>6</u> Feet Below Land Surface	Well yielded <u>14</u> GPM with a drawdown of
Test Pumping Rate: <u>14</u> Gallons Per Minute	<u>6</u> feet after _____ hours of pumping
Duration of Pump Test (minimum 4 hours): _____ hours	

I HEREBY CERTIFY that the above statements are true to the best of my knowledge.

Robert Smith 0-645
 Print Name of Pump Installer and License No. (if applicable)

[Signature]
 Signature of Pump Installer