County: Late	Well Driller Report and Well Log		For Office Use Only:		
Permit #:	Mississippi Department of Environmental Quality		Well #: B-125		
Driller: FLANGFORD	Office of Land a	nd Water Resources			
Date drilling completed: 3-14-06	P.O. Box 10631 Jackson, MS 39289-0631		L. S. Elevation:		
	(601)	961-5210	E-log #:		
	(601)354	4-6938 (fax)			
State Law requires that this 30 days of completion of dri	report be prepared by the lling of the well.	driller in detail and filed wit			
Well Owner Information		Well Location			
Owner Name DAVA For	Nder BLAK SA.				
Mailing Address: 5289 Kury 306		Method of Lat/Long (circle one): Conventional Survey,			
		USGS quad, Hand-held GPS, Survey-grade GPS			
<u>Cold wa</u> City	TenM15StateZip Code	¼¼ Sec_ <b>2_</b>	5 Twn 4 9 Rng 7 4		
Telephone No. ()	•	Distance Direction	Nearest Town of <u>INDEPENSENC</u>		
	Well	Data			
Purpose of Well (circle one) (Home	Industrial Public Suppl	v Irrigation Fish Cultur	re Other:		
Date well drilling started:3					
If flowing, method of flow regulation					
Static Water Level: <u>65</u> f	eet above or below (circle or	e) land surface Date measu	$rred: 0^{-}/0^{-}/0^{-}$		
Method of Measurement (circle one)	steel tape electric ta	ape air line other: _			
Hole depth: <u>130</u> We	ell depth: 130	Well grouted to a depth	of <u> </u>		
Type of grout (circle one): Cemen					
Casing length: <u>feet</u> Casing diameter: <u>H</u> inches Type of casing: <u>PUC</u>					
Screen length: <u>10</u> feet Screen diameter: <u><math>W</math></u> inches Type of screen: <u><math>510710</math> pvc</u>					
Screen slot size: <u>. 013</u> inc	hes Setting depth: From				
Type of completion (circle all applica	able): Gravel packed Un	derreamed Telescoped	Open hole Natural Development		
	Other (describe):				
Top of lap pipe or reduction in casing	feet. I	f telescoped or more than on	e screen, describe on back of page		
Logs run (circle all applicable): No l	og run Electric Gamma I	Ray Density Sonic Neutro	on Other:		
Name of organization running log(s): I certify that the well was drilled, construct	ed, and completed in accordance	with all applicable requirements of t	the Mississippi Department of		
Environmental Quality and/or the Mississippi Department of Health regulations and state laws.					
		Frank	$\mathcal{P}\mathcal{A}$ 0		
FANNELNNGFON Print Name of Water Well Contracto			of Water Well Contractor		
If well telescopes please sketch belo			MAR 3 0 2006		

•..

...\*

**BY: OLWR** 

ン

		Part 2	Far Officer Ese Only	
County	Pump Installer	's Completion Report		
Permit =	Mississippi Department of Environmental Quality		Non-fer Wer B-125	
Driller RhANGfork	Office of Land and Water Resources P.O. Box 10631		1	
Date completed 3-19-06	Jackson, MS 39289-0631		Elevatar	
: المربوب میں		1)961-5210 154-6938 (fax)		
	ed by the pump installer i	n detail and filed with the De	partment within 30 days of the	
mstallation of pump. A copy Well Owner Info		nust be attached to this report	t. I Location	
Owner Name: DAVR FO	Ndik Kipta			
		Latitude:		
Mailing Address: <u>52 69 //</u>	wy 306	Method of Lat/Long (circle	one): Conventional Survey,	
		USGS quad, Hand-held GPS, Survey-grade GPS		
Caldun Ter MS. City State Zip Code		V. Sec 2	LS TWO XI & Rno DIA	
		Distance Direction Nearest Town		
Telephone No. ()		MilesW	of INdependence.	
B				
Pump Type Circle one			ver Type	
Air Fift Jet	Submersible			
			ne Engine Naturai Ga	
Bucket Piston	Turbine	Electric Motor Hand	Tractor PTC	
Centrifugal Rotary	Flowing Well	Windmill Other	(specify):	
Other (specify):		Horse Power Rating of Motor	34	
Date Pump Installed: 3-19-06		Setting Depth. 100	feet	
Rated Pump Capacity: 12				
		Number of Stages.		
Pump Test Dat	3	Method of Meas	uring Water Level	
Date Well Tested: 3-18-			le one	
		Air Line Electric Mea	suring Line Steel Tape	
tatic Water Level (A) <u>65</u> Feer Below Land Surface		Other (specify):		
umping Water Level (B): 69 F	eet Below Land Surface	and any other states and an		
rawdown [(B) - (A)]:F	eet Below Land Surface	For flowing well, measured sh	ut in head:feet	
est Pumping Rate: 15 +				
uration of Pump Test (minimum 4 hou	nz): <u>A</u> ponz	<b>O</b> feet after	<u>hours of pumping</u>	
HEREBY CERTIFY that the above sta	tamont on this to the here	of my knowledge		
			- Lave	
int Name of Pump Installer and Licens	UNGRE	Signature of Pump Installe	DECENVER	

۲


B-125

	Description of Formations Encountered	From To
Ground Level		05
	Red SANC SANC/Minede W/SANC	5 15
	GANO/Minede	14 19 40
	WI SANC	NO 180
	~~~~~~~~~~~~~~~~~~~~~~~~~~~~~~~~~~~~~~~	

If more than one screen, show location of each on sketch

۹.,

Sketch the property layout and include the following: 1) the well location; 2) any permanent structures on the property that may aid in locating the well; 3) any roads, power lines, or other items that may aid in locating the property and the well; 4) indicate direction.

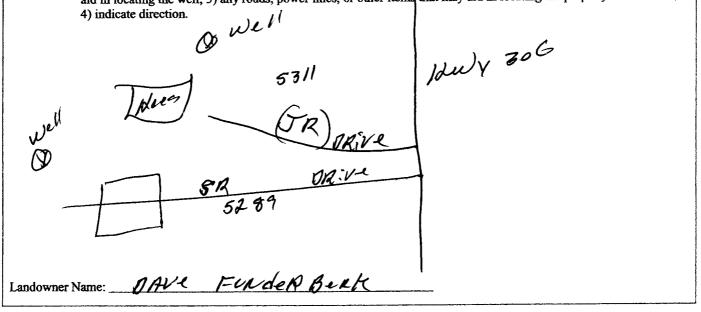

Signature of Water

RECEIVED MAR 3 0 2006 **BY: OLWR**