

# State Well Report

Part 1

Mississippi Department of Environmental Quality

Office of Land and Water Resources

P.O. Box 2309  
Jackson, MS 39225

For Office Use Only
Aquifer: <u>B207</u>
Well #: _____
L.S. Elevation: _____
E-Long #: _____

County: <u>ITTC</u>
Permit #: _____
Driller: <u>BOB SMITH</u>
Date drilling complet: <u>10-28-09</u>

State Law requires that this report be prepared by the driller in detail and filled will the Department within 30 days of completion of drilling of the well.

Well Owner Information	Well Location
Owner Name: <u>AMBER ALISON</u>	Latitude: <u>34° 41' 12"</u> Longitude: <u>90° 02' 09"</u>
Mailing Address: <u>2900 AMBERWOOD</u> <u>COLUMBIA, MS 38618</u>	Method of Lat/Long (circle one): Conventional Survey, USGS quad, Hand-held GPS, Survey-grade GPS
City: _____ State: _____ Zip Code: _____	SE 1/4 SW 1/4 Sec <u>R24</u> Twn <u>T4S</u> Rng <u>R8W</u>
Telephone No. <u>(602) 473-0997</u>	Distance: <u>3 1/2</u> Miles Direction: <u>W</u> of <u>COLUMBIA</u>

Well Data	
Purpose of Well (circle one) <u>Home</u> Industrial Public Supply Irrigation Fish Culture Other _____	
Date well drilling started: <u>10-28-09</u> Date well drilling completed: <u>10-28-09</u>	
If flowing, method of flow regulation: Valve _____ Other (describe) _____	
Static Water Level: <u>35</u> feet above of <u>below</u> (circle one) land surface Date measured: <u>10-28-09</u>	
Method of Measurement (circle one) steel tape electric tape air line other: <u>WELL WEIGHT</u>	
Hole Depth: <u>146</u> Well depth: <u>146</u> Well grouted to a depth of <u>10</u> feet	
Type of grout: (circle one) <u>Cement</u> Bentonite Mix	
Casing length: <u>136</u> feet Casing diameter: <u>4</u> inches Type of casing: <u>PVC</u>	
Screen length: <u>10</u> feet Screen diameter: <u>4</u> inches Type of screen: <u>PVC</u>	
Screen slot size: <u>13 THOUS</u> inches Setting depth: From <u>136</u> feet to <u>146</u> feet	
Type of completion (circle all applicable): <u>Gravel packed</u> Underreamed Telescoped Open hole Natural Development Other (describe): _____	
Top of lap pipe or reduction incasing: _____ feet. If telescoped or more than one screen, describe on back	
Logs run (circle one): No log run Electric Gamma Ray Density Sonic Neutron Other: _____	
Name of oorganization running log(s): _____	

I certify that the well drilled, constructed, and completed in accordance with all applicable requirements of the Mississippi Department of Environmental Quality and/or the Mississippi Department of Health regulations and state laws.


BOB SMITH 0645  
Print name of Water Contractor and License No.

[Signature]  
Signature of Water Well Contractor

RECEIVED  
NOV 30 2009  
BY: OLWR


B207

Ground Level

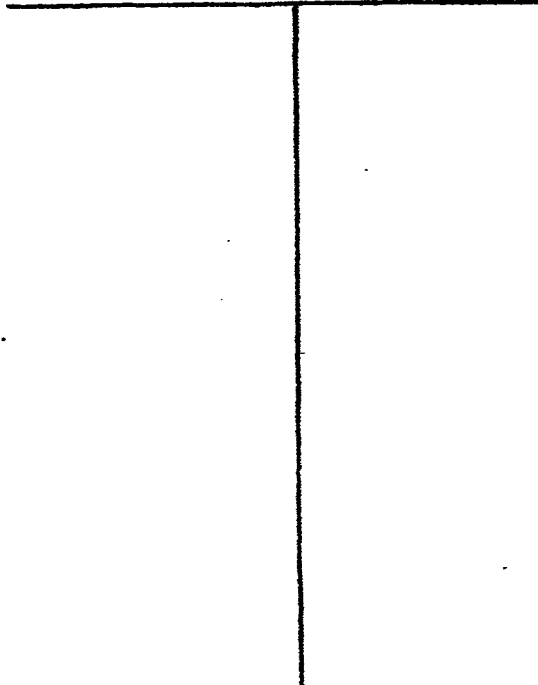

Description of Formations Encountered	From	To
TOP SOIL	0	5
BROWN CLAY	5	20
GRAVEL	20	24
WHITE CLAY	24	83
WHITE CLAY SAND	83	110
WHITE SAND	110	146

If more than one screen, show location of each on sketch

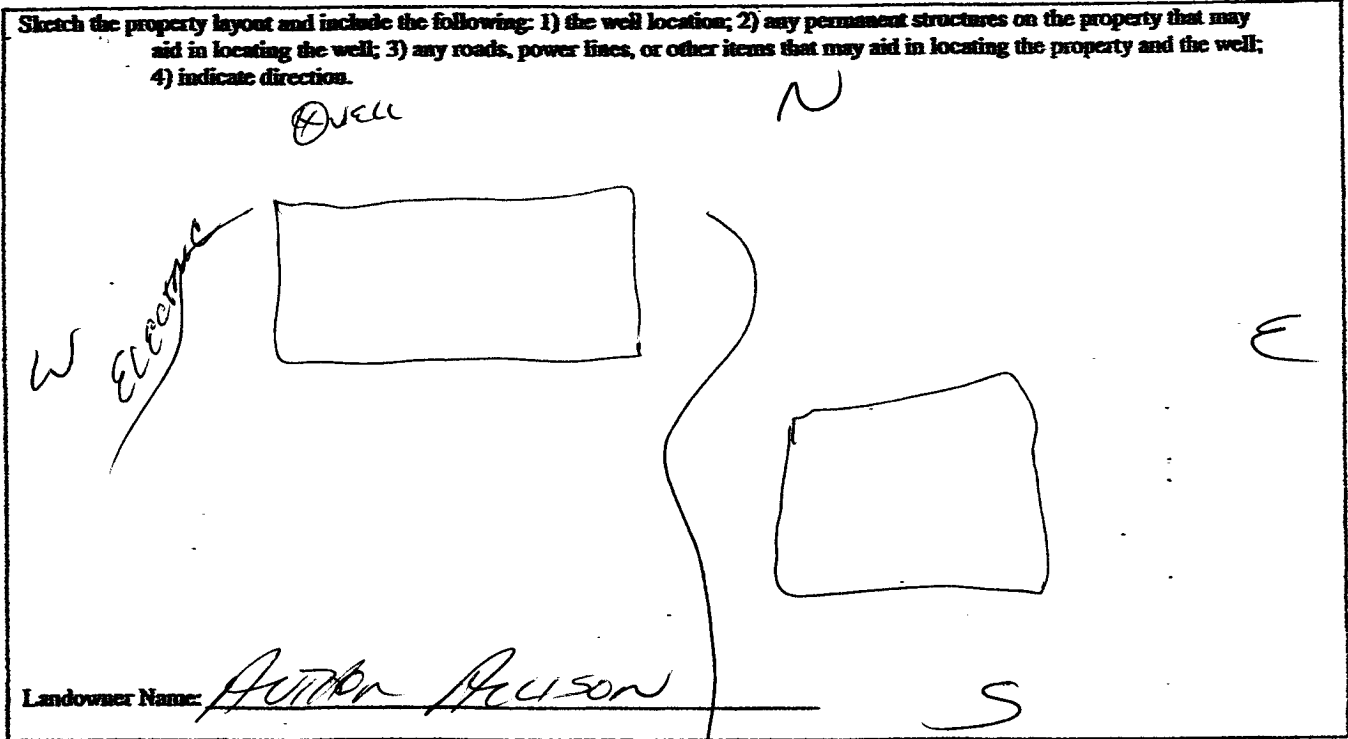

*[Handwritten Signature]*  
 Signature of Water Well Contractor

RECEIVED  
 NOV 3-8 2001  
 BY: OLWR

# State Well Report

Part 2

## Pump Installer's Completion Report

Mississippi Department of Environmental Quality

Office of Land and Water Resources

P.O. Box 2309

Jackson, MS 39225

For Office Use Only
Aquifer: <u>B207</u>
Well #: _____
Elevation: _____

County: <u>ITTE</u>
Permit #: _____
Driller: <u>Bob Smith</u>
Date completed: <u>10-28-09</u>

**This report be prepared by the pump installer in detail and filled will the Department within 30 days of completion of drilling of the well.**

Well Owner Information	Well Location
Owner Name: <u>Arthur Alson</u>	Latitude: <u>34°41'12"</u> Longitude: <u>90°02'09"</u>
Mailing Address: <u>2900 ALABAMA RD</u>	Method of Lat/Long (circle one): Conventional Survey
<u>Collierville, MS 38618</u>	USGS quad, Hand-held GPS, survey grade GPS
City State Zip Code	<u>SE 1/4 SW 1/4 Sec 34 Twn 14 S Rng 18 W</u>
Telephone No. <u>662 473-0997</u>	Distance Direction Nearest Town
	<u>3 1/2</u> miles <u>W</u> of <u>Collierville</u>

Pump Type Circle one	Power Type Circle one
Air lift Jet <input checked="" type="radio"/> Submersible	Diesel Engine Gasoline Engine Natural Gas
Bucket Piston Turbine	<input checked="" type="radio"/> Electric Motor Hand Tractor PTO
Centrifugal Rotary Flowing Well	Windmill Other(specify): _____
Other (specify): _____	Horse Power Rating of Motor: <u>3/4</u>
Date Pump Installed: <u>10-28-09</u>	Setting Depth: <u>60</u> feet
Rated Pump Capacity: <u>12</u> gallons per min	Number of Stages: <u>11</u>

Pump Test Data	Method of Measuring Water Level circle one
Date Well Tested: <u>10-28-09</u>	Air Line Electric Measuring Line Steel Tape
Static Water Level(A): <u>35</u> feet below Land Surface	Other(specify): <u>LINE &amp; WEIGHT</u>
Rumping Water Level(B): _____ feet below Land Surface	For flowing well, measured shut in head: _____ feet
Drawdown[(B)-(A)]: _____ feet below Land Surface	Well yielded <u>16</u> GPM with a drawdown of
Test Pumping Rate: <u>16</u> gallons per Minute	_____ feet after _____ hours of pumping
Duration of Pump Test(minimun 4 hours): _____ hrs	

I HEREBY CERTIFY that the above statements are true to the best of my knowledge.

Bob Smith 0645 \_\_\_\_\_  
 Print Name of Pump Installer and License No. Signature of Pump Installer

RECEIVED

NOV 30 2009

BY: OLWR