

State Well Report

Part 1

Mississippi Department of Environmental Quality
Office of Land and Water Resources
P.O. Box 2309
Jackson, MS 39225

For Office Use Only

Aquifer: _____
Well #: B215
L.S. Elevation: _____
E-Long #: _____


County: JACKSON
Permit #: _____
Driller: Bob Smart
Date drilling complet: 8-9-12

State Law requires that this report be prepared by the driller in detail and filed with the Department within 30 days of completion of drilling of the well.

Well Owner Information	Well Location
Owner Name: <u>J B Hunsucker</u>	Latitude: <u>34-41-32</u> Longitude: <u>89-56-10</u>
Mailing Address: <u>6975 Peyton Rd</u>	Method of Lat/Long (circle one): Conventional Survey, USGS quad, Hand-held GPS, Survey-grade GPS
<u>COLUMBIA, MS 38418</u>	<u>NE 1/4 SE 1/4 Sec 31 Twn 14S Rng R2W</u>
City State Zip Code	Distance Direction Nearest Town
Telephone No. ()	<u>3</u> Miles <u>E</u> of <u>COLUMBIA</u>
Well Data	
Purpose of Well (circle one) <u>Home</u> Industrial Public Supply Irrigation Fish Culture Other	
Date well drilling started: <u>8-9-12</u> Date well drilling completed: <u>8-9-12</u>	
If flowing, method of flow regulation: Valve _____ Other (describe) _____	
Static Water Level: <u>60</u> feet above of <u>below</u> (circle one) land surface Date measured: _____	
Method of Measurement (circle one) steel tape electric tape air line other <u>LINE + WEIGHT</u>	
Hole Depth: _____ Well depth: _____ Well grouted to a depth of <u>10</u> feet	
Type of grout: (circle one) <u>Cement</u> Bentonite Mix	
Casing length: <u>140</u> feet Casing diameter: <u>4</u> inches Type of casing: <u>PVC</u>	
Screen length: <u>10</u> feet Screen diameter: <u>4</u> inches Type of screen: <u>PVC</u>	
Screen slot size: <u>13 THOUS.</u> inches Setting depth: From <u>130</u> feet to <u>140</u> feet	
Type of completion (circle all applicable): <u>Gravel packed</u> Underreamed Telescoped Open hole Natural Development Other (describe): _____	
Top of lap pipe or reduction casing: _____ feet. If telescoped or more than one screen, describe on back	
Logs run (circle one): No log run Electric Gamma Ray Density Sonic Neutron Other: _____	
Name of organization running log(s): _____	
I certify that the well drilled, constructed, and completed in accordance with all applicable requirements of the Mississippi Department of Environmental Quality and/or the Mississippi Department of Health regulations and state laws.	
<u>Bob Smart 0-645</u>	<u>[Signature]</u> RECEIVED
Print name of Water Contractor and License No.	Signature of Water Well Contractor

AUG 21 2012
BY: OLWR


Ground Level

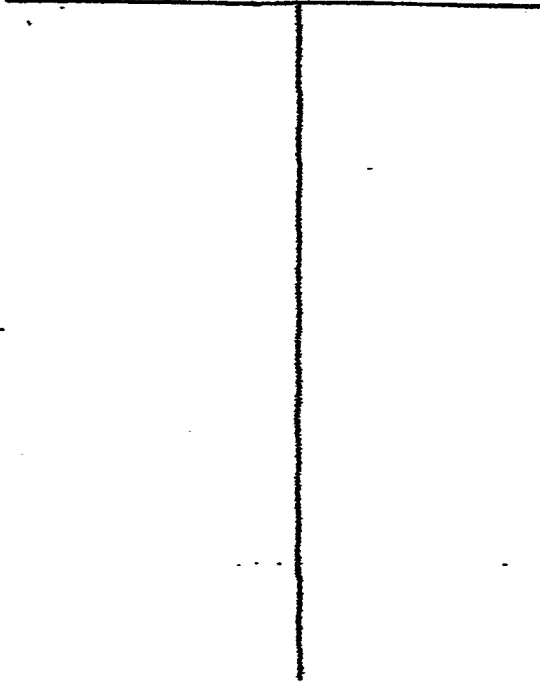

Description of Formations Encountered	From	To
TOP SOA	0	5
BROWN CLAY	5	28
WHITE SAND & CLAY	28	40
WHITE CLAY	40	110
WHITE SAND	110	140

If more than one screen, show location of each on sketch

Sketch the property layout and include the following: 1) the well location; 2) any permanent structures on the property that may aid in locating the well; 3) any roads, power lines, or other items that may aid in locating the property and the well; 4) indicate direction.

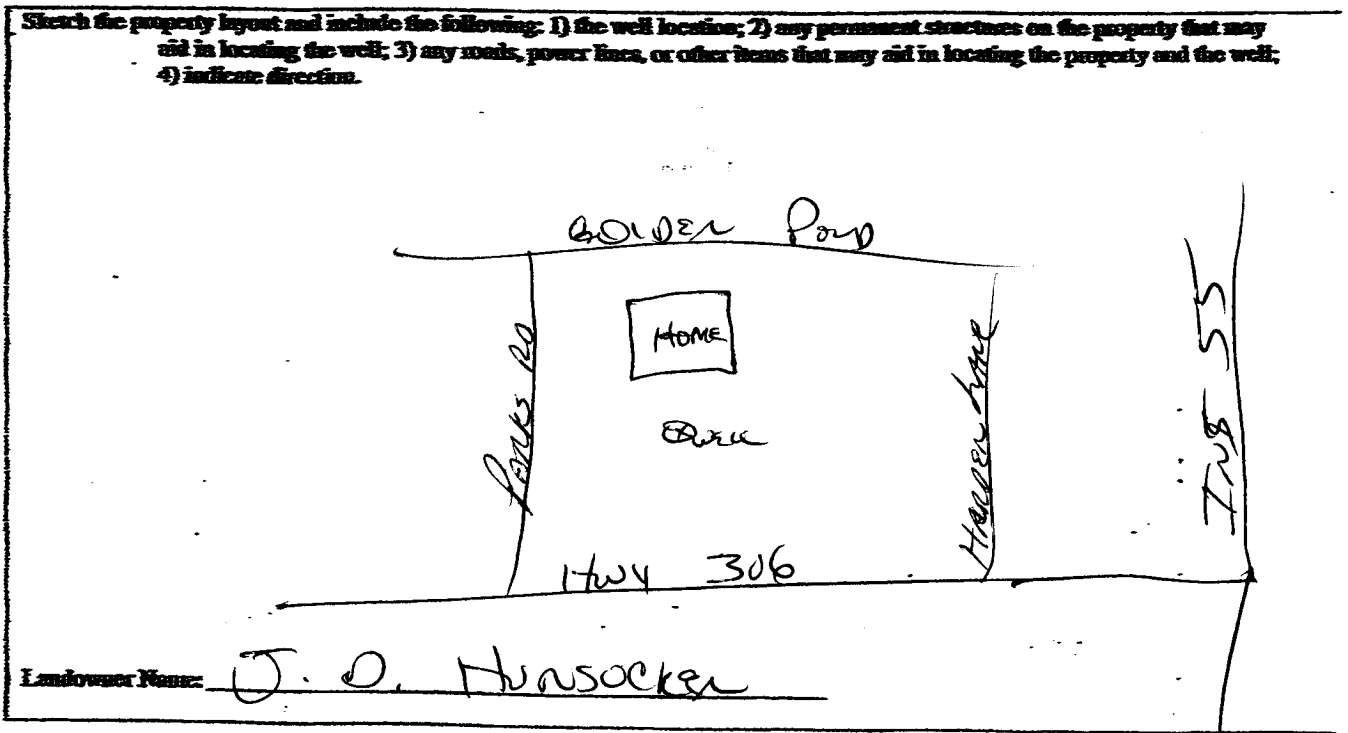

Landowner Name: J. O. Hunsicker

[Signature]
Signature of Water Well Contractor

RECEIVED
AUG 24 2012
BY OLWA

State Well Report

Part 2

Pump Installer's Completion Report
 Mississippi Department of Environmental Quality
 Office of Land and Water Resources
 P.O. Box 2309
 Jackson, MS 39225

For Office Use Only	
Aquifer: _____	Well #: <u>B.215</u>
Elevation: _____	_____

County: <u>TATE</u>
Permit #: _____
Driller: <u>BOB SMITH</u>
Date completed: <u>8-9-12</u>

This report be prepared by the pump installer in detail and filled with the Department within 30 days of completion of drilling of the well.

Well Owner Information	Well Location
Owner Name: <u>J.D. Hunsycken</u>	Latitude: _____ Longitude: _____
Mailing Address: <u>6975 Parks Rd</u>	Method of Lat/Long (circle one): <input checked="" type="radio"/> Conventional Survey
<u>Collierville, MS. 38618</u>	USGS quad, Hand-held GPS, survey grade GPS
City State Zip Code	<u>NE1/4 SE1/4 Sec 20 Twn 14S Rng 12W</u>
Telephone No. () _____	Distance Direction Nearest Town
	<u>3 miles E of Collierville</u>

Pump Type Circle one	Power Type Circle one
Air lift Jet <input checked="" type="radio"/> <u>Submersible</u>	Diesel Engine Gasoline Engine Natural Gas
Bucket Piston Turbine	<input checked="" type="radio"/> <u>Electric Motor</u> Hand Tractor PTO
Centrifugal Rotary Flowing Well	Windmill Other(specify): _____
Other (specify): _____	Horse Power Rating of Motor: <u>3/4</u>
Date Pump Installed: <u>8-9-12</u>	Setting Depth: <u>80</u> feet
Rated Pump Capacity: <u>10</u> gallons per min	Number of Stages: <u>8</u>

Pump Test Data	Method of Measuring Water Level circle one
Date Well Tested: <u>8-9-12</u>	Air Line Electric Measuring Line Steel Tape
Static Water Level(A): <u>60</u> feet below Land Surface	Other(specify): <u>LINE + WEIGHT</u>
Pumping Water Level(B): _____ feet below Land Surface	For flowing well, measured shut in head: _____ feet
Drawdown[(B)-(A)]: _____ feet below Land Surface	Well yielded <u>14</u> GPM with a drawdown of _____ feet after _____ hours of pumping
Test Pumping Rate: <u>14</u> gallons per Minute	
Duration of Pump Test(minimum 4 hours): _____ hrs	

I HEREBY CERTIFY that the above statements are true to the best of my knowledge.

<u>Bob Smith 0645</u>	
Print Name of Pump Installer and License No.	Signature of Pump Installer

RECEIVED
 AUG 21 2012
 BY: OLWB