State W	ell Report			
l -	Oriller's Log	For Office Use Only:		
Mississippi Departmen	Mississippi Department of Environmental Quality			
	Office of Land and Water Resources			
1 5 91 1	Box 2309 i, MS 39225	Well #: <u>B217</u>		
(601)9	961- 5210	L. S. Elevation:		
	1- 5228 (fax)	E-log#:		
		· · · · · · · · · · · · · · · · · · ·		
State Law requires that this report be prepared by the license holder responsible for the work and filed with the Department at the above address within 30 days of completion of drilling of the well or borehole.				
Information on Well Owner		ehole Location		
(Landowner if borehole is not for a water well)				
Owner Name Doniel Brooks	Latitude: 34 ° 44 , 13, 7	" Longitude: 89 • 54 ,49.64		
Owner Name PONIEL DIOOKS	Method of Lat/Long (circle one	a). Conventional Survey		
Mailing Address: 3984 Polestine 1d		Conventional Survey,		
	USGS quad, Hand-held (GPS) Survey-grade GPS		
	S(2) 11/2 0 14	7 46/2 20		
(aldwater one 3 Palal Swy NW/4 Sec 14 Twn 45 Rng 70		1 kng 7 65		
City State Zip Code	Distance Direction	Nearest Town		
Telephone No. (662) 501-0655	<u> 3314</u> Miles <u>νω</u> ο	f Antioch		
Telephone No. (867) 30(70813				
Well / Borehole Data				
	A	.011		
Date drilling started: (19-11-12) Date drilling completed: (19-11-1	Hole depth: 000	Hole diameter: 18		
Location of the source of any surface water used for drilling:				
Method of dosing and volume of Chlorine used in drilling and development:				
Lace was (single all and limble). Will Flori in G. B.	D 1: 0 1 37			
Logs run (circle all applicable): Xo log run Electric Gamma Ray Density Sonic Neutron Other: Name of organization running log(s):				
Purpose of borehole (check one): Water Well Geotechnical/Geological Investigation Ground Source Heat Pump				
Seismic Survey Other (describe)				
If drilling is not related to water well construction		<u> </u>		
Purpose of Well (check one): Home Industrial Public Supply Irrigation Fish Culture Other:				
If a flowing well, method of flow regulation: Valve Other (describe)				
Static Water Level:				
Method of Measurement (circle one) steel tape electric tape air line other: String weight				
Well depth: 200 Well grouted to a depth of 50 feet Type of grout (circle one): Neat Cement Bentonite Mix				
Casing length: 160 feet Casing diameter: 12 inches Type of casing: PUC				
Screen length: 40 feet Screen diameter: 12 inches Type of screen: puc				
Screen slot size:inches Setting depth: Fromfeet tofeet				
Type of completion (circle all applicable): Gravel packed Underreamed Telescoped Open hole Natural Development				

Other (describe): _

Top of lap pipe or reduction in casing:

Form: OLWR-SWR-14 (04798)

feet. If telescoped or more than one screen, describe on next page



The sketch below only required for water wells


If well telescopes, show depths on sketch.

Ground Level

Description of formations encountered must be provided for all wells and boreholes, unless specifically exempted by regulations

Description of Formations Encountered	From (depth)	To (depth)
clay dirt	Ground Level	92_
white soud	92_	35
Red Soud	35	50
grovel	50	60
i iite smid	60	(10
white sound	110	150
white said	170	300

If more than one screen, show location of each on sketch

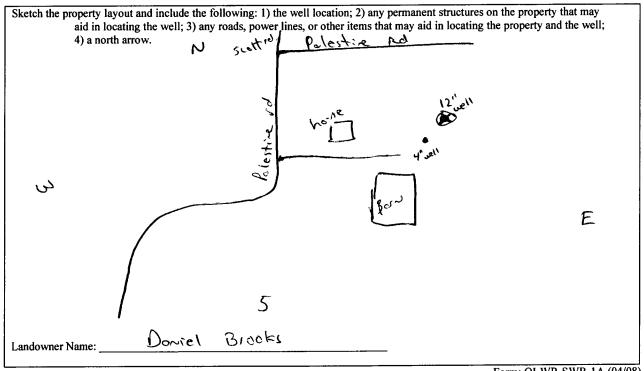

Form: OLWR-SWR-1A (04/08)

I certify that the well/borehole was drilled, constructed, and completed in accordance with all applicable requirements of the Mississippi Department of Environmental Quality and the Mississippi Department of Health regulations, if applicable, and state

Print Name of Responsible Licensee and License No	. Date	Signature of Licensee
Jones w. Moson 0-620	11-8-12	Janu Maria 19010
	• • • • • • • • • • • • • • • • • • • •	

BY: OLWA

STATE WELL REPORT Part 2 Tete County: For Office Use Only: **Pump Installer's Completion Report** Mississippi Department of Environmental Quality Permit #: Aquifer: Office of Land and Water Resources Driller: James w. Mosal P.O. Box 2309 Balt Well #: Jackson, MS 39225 Date completed: 10-35-12 (601)961-5210 Elevation: (601)961-5228 (fax) Copy information from block on Part 1 This part of the report must be completed by a licensed water well contractor or a licensed pump installer. A copy of Part 1 of the report must be attached and both parts filed with the Department at the above address within 30 days of well completion. Well Owner Information Latitude: 34.44.13.71 Longitude: 89.54, 49.64 Owner Name: Deniel Brooks 2984 polertime rd. Method of Lat/Long (check one): Conventional Survey____, Mailing Address: USGS quad , Hand-held GPS , Survey-grade GPS___ City State SW 4 NW 4 Sec 14 T 45 R 700 Nearest Town Distance Direction 3/4 Miles NW of Antioch Telephone No. (667) 501 - 0655 Power Type Pump Type Circle one Circle one Natural Gas Gasoline Engine Diesel Engine Submersible Air Lift let Tractor PTO Electric Motor Hand Piston Turbine Bucket Windmill Other (specify): Flowing Well Centrifugal Rotary Horse Power Rating of Motor: 40 Other (specify): Setting Depth: ______ & O Date Pump Installed: 10-35-12 feet Rated Pump Capacity: 450 Gallons Per Minute Number of Stages: _ Method of Measuring Water Level Pump Test Data Circle one Date Well Tested: 10-35-12 Steel Tape Air Line Electric Measuring Line Static Water Level (A): ______ Feet Below Land Surface Other (specify): String weigh Pumping Water Level (B): Feet Below Land Surface Drawdown [(B) – (A)]: ______Feet Below Land Surface For flowing well, measured shut in head: ______feet 450 Test Pumping Rate: Gallons Per Minute Well yielded GPM with a drawdown of ∂4 __hours of pumping feet after Duration of Pump Test (minimum 4 hours): ______hours

I HEREBY CERTIFY that the above statements are true to the best of my knowledge.

V-650

Print Name of Pump Installer and License No. (if applicable)

Janes W. Moson

Form: OLWR-SWR-1B (04/08)

Signature of Pump Installer