

B 2000

7-66

WATER WELL DRILLERS LOG


Date: July 9, 1966, Driller: Shelby Newman County Tate  
(Name)

	Description & Color of Materials Sand, Clay, Red Clay, Shell, etc.	Thick- ness Feet	Depth Feet
(1) Owner of Land: <u>B. C. Ditchman</u> <small>(Name)</small> <u>Coldwater Miss</u> <small>(Address)</small>	<u>Red Clay</u>	<u>35</u>	<u>35</u>
(2) Location: <u>SW 1/4, NW 1/4, Sec. 34 T4R8E</u> <u>4</u> miles <u>west</u> of <u>Coldwater</u> <small>(distance) (direction) (Nearest Town)</small>	<u>Gravel</u> <u>White Clay</u>	<u>10</u>	<u>50</u> <u>60</u>
(3) Topography: <u>Hilly</u> <small>(Hilly) (Flat) (Level)</small>	<u>Blue Clay</u>	<u>20</u>	<u>80</u>
(4) Purpose of Well: <u>Domestic</u> <small>(Domestic Irrigation Municipal, Industrial, Other)</small>	<u>White Clay</u> <u>White Sand</u>	<u>10</u> <u>19</u>	<u>90</u> <u>109</u>

Information upon completion of well:

- (1) Diameter 2 inches.
- (2) Total Depth 109 feet.
- (3) Water Level 90 feet below top of ground.
- (4) Cased to 84, Size 2 in.
- (5) Screen: Size 90 mesh, Length 6 ft.
- (6) Were any formations sealed against pollution?  
 yes,  no.

If YES depth of formation \_\_\_\_\_  
 Why \_\_\_\_\_  
 Drillers Remarks: \_\_\_\_\_

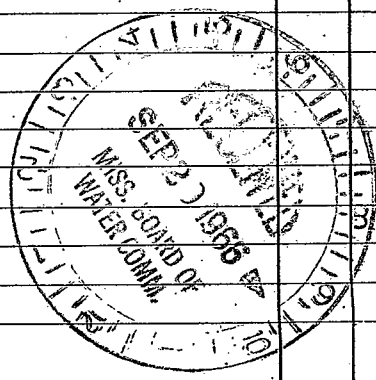

(Use Back Side)

Well No.

Handwritten notes at the top of the page, possibly including a date or title.

Main body of handwritten text, appearing to be a list or series of entries.

Vertical handwritten notes on the right side of the page.

Handwritten notes in the lower middle section of the page.

A single handwritten mark or character at the bottom right.