


late
B 2001
7-66

MISSISSIPPI BOARD OF WATER COMMISSIONERS

WATER WELL DRILLERS LOG

Date: July 9, 1966, Driller: Shelly Neyman County late
(Name)

| (1) Owner of Land: | Description & Color of Materials Sand, Clay, Red Clay, Shell, etc. | Thick- ness Feet | Depth Feet |
|--|---|------------------------|---------------|
| <u>O.C. Ditchman</u> (Name) <u>Coldwater Miss</u> (Address) | <u>Red clay</u> | <u>35</u> | |
| (2) Location: <u>SW 1/4, NW 1/4, Sec. 34 T 48 R 4</u> <u>4</u> miles <u>west</u> of <u>Coldwater</u> (distance) (direction) (Nearest Town) | <u>Gravel</u> | <u>13</u> | |
| (3) Topography: <input checked="" type="checkbox"/> (Hilly) <input type="checkbox"/> (Flat) <input type="checkbox"/> (Level) | <u>white clay</u> | <u>10</u> | |
| (4) Purpose of Well: <input checked="" type="checkbox"/> (Domestic Irrigation) <input type="checkbox"/> (Municipal, Industrial, Other) | <u>Blue clay</u> | <u>20</u> | |
| Information upon completion of well: | | | |
| (1) Diameter <u>2</u> inches. | <u>white clay</u> | <u>10</u> | |
| (2) Total Depth <u>109</u> feet. | <u>white sand</u> | <u>19</u> | |
| (3) Water Level <u>90</u> feet below top of ground. | | | |
| (4) Cased to <u>105</u> , Size <u>2"</u> | | | |
| (5) Screen: Size <u>90%</u> , Length <u>6ft</u> | | | |
| (6) Were any formations sealed against pollution? <u>no</u> | | | |
| If YES depth of formation _____ | | | |
| Why _____ | | | |
| Drillers Remarks: _____ | | | |

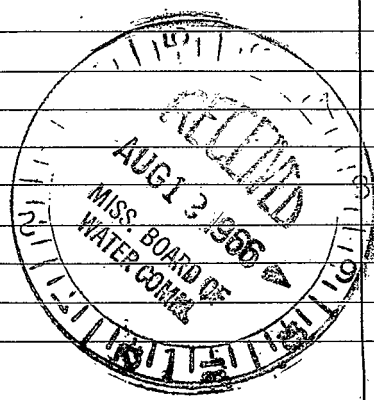

(Use Back Side)

Well No.

