

Zate
B 2002
11-66

MISSISSIPPI
 BOARD OF WATER COMMISSIONERS
 416 North State Street
 Jackson, Mississippi 39201

WATER WELL DRILLERS LOG

11 1966 Harris Bros Zate
 date well completed firm name county well located

LANDOWNER: W. H. Frazier
Rte. 3
Coldwater Miss
 (mailing address)

| description of formations encountered | from | to |
|---------------------------------------|-----------|------------|
| <u>top soil</u> | <u>0</u> | <u>20</u> |
| <u>red sand</u> | <u>20</u> | <u>45</u> |
| <u>white clay sand</u> | <u>45</u> | <u>85</u> |
| <u>Course white sand</u> | <u>85</u> | <u>100</u> |

WELL LOCATION:
 sec. 1 T 4 N R 7 E
5 miles NW of Independence
 (distance) (direction) (nearest town)

WELL PURPOSE: home
 (home, irrigation, municipal, industrial)

WELL COMPLETION DATA:

(1) diameter (inches) 4

(2) total depth (feet) 100

(3) static water level (feet) 40 below top of ground.

(4) casing Plastic 93' (material) (depth)

.008 if telescope see back. (size)

(5) screen 7' 93' (length) (depth to top)

4" Plastic (size) (material)


(6) pump 3/4 7 (HP) (yield gpm)

elec. (type power)

(7) electric log no (yes or no)

(organization running log)


(8) how well bottom plugged back
snaps

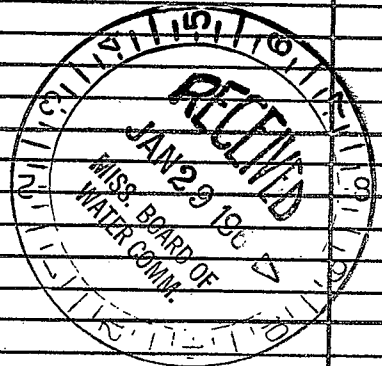

DRILLERS REMARKS:

If well telescopes please sketch and show depths.

GROUND LEVEL

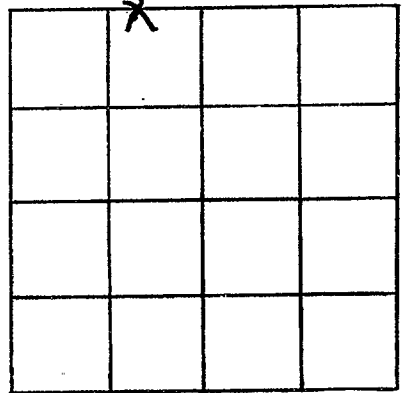

SECTION 1

Please indicate well location X.

ADDITIONAL INFORMATION

Lined area for additional information.

If more than one screen, show locations of each on sketch.