

Date
13 2003
4-67

MISSISSIPPI
 BOARD OF WATER COMMISSIONERS
 416 North State Street
 Jackson, Mississippi 39201

WATER WELL DRILLERS LOG

4-2 date well completed 1967 Harris Bros. firm name Zato county well located

LANDOWNER: J.M. Carlisle
pte. 2
Caldwate, Miss.
 (mailing address)

description of formations encountered	from	to
<u>top soil</u>	<u>0</u>	<u>20</u>
<u>sand</u>	<u>20</u>	<u>65</u>
<u>clay</u>	<u>65</u>	<u>85</u>
<u>white sand</u>	<u>85</u>	<u>100</u>


WELL LOCATION:
 sec 32 T 4 N R 7 E
1/2 miles W of Caldwate
 (distance) (direction) (nearest town)

WELL PURPOSE: home
 (home, irrigation, municipal, industrial)

WELL COMPLETION DATA:


- (1) diameter (inches) 4
- (2) total depth (feet) 100
- (3) static water level (feet) 60 ^(below) _{above} top of ground.
- (4) casing Plastic, 93
 (material) (depth)
4 If telescope see back.
 (size)
- (5) screen 7', 93'
 (length) (depth to top)
008, Plastic
 (size) (material)
- (6) pump 3/4, 7
 (HP) (yield gpm)
abc
 (type power)
- (7) electric log no
 (yes or no)
 (organization running log)
- (8) how well bottom plugged back
shot

DRILLERS REMARKS:

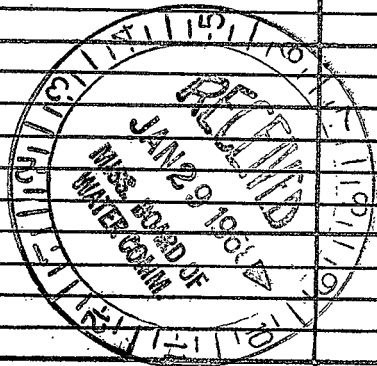

If well telescopes please sketch and show depths.

GROUND LEVEL

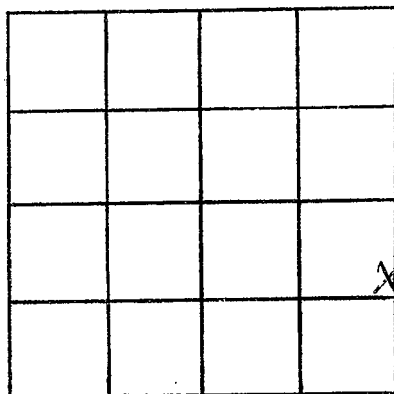

SECTION 32

Please indicate well location X.

ADDITIONAL INFORMATION

If more than one screen, show locations of each on sketch.