

Info
B 2005
8-11-75

MISSISSIPPI
 BOARD OF WATER COMMISSIONERS
 416 North State Street
 Jackson, Mississippi 39201
 WATER WELL DRILLERS LOG

8-11 1975 Harris Bros. Info
 date well completed firm name county well located

LANDOWNER: J. A. Jackson
Rt 3
Coldwater
 (mailing address)


description of formations encountered	from	to
<u>top soil</u>	<u>0</u>	<u>15</u>
<u>clay + sand</u>	<u>15</u>	<u>105</u>
<u>coarse sand</u>	<u>105</u>	<u>120</u>

WELL LOCATION:
 sec 23 T 4 N R 7 E ¹⁵⁶
2 miles NW of Bowman
 (distance) (direction) (nearest town)

WELL PURPOSE: home
 (home, irrigation, municipal, industrial)

- WELL COMPLETION DATA:
- (1) diameter (inches) 4
 - (2) total depth (feet) 120
 - (3) static water level (feet) 80 ^{below} _{above} top of ground.
 - (4) casing plastic, 113
 (material) (depth)
4 If telescope see back.
 (size)
 - (5) screen 7, 113
 (length) (depth to top)
008, plastic
 (size) (material)
 - (6) pump 3/4, 10
 (HP) (yield gpm)
elec.
 (type power)
 - (7) electric log no
 (yes or no)
- (organization running log)
- (8) how well bottom plugged solid

DRILLERS REMARKS:

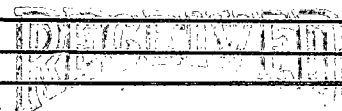

OCT 28 1975

If well telescopes please sketch and show depths.

GROUND LEVEL

			X

SECTION 23

Please indicate well location X.

ADDITIONAL INFORMATION

If more than one screen, show locations of each on sketch.